

BRITISH COLUMBIA
PROSPECTORS ASSISTANCE PROGRAM
MINISTRY OF ENERGY AND MINES
GEOLOGICAL SURVEY BRANCH


PROGRAM YEAR: 1996/1997

REPORT #: PAP 96-8

NAME: DAVID JAVORSKY

To Mr. Vic Preto
MANAGER PROSPECTORS ASSISTANCE
GEOLOGICAL SURVEY BRANCH
Fifth Floor 1810 Blanchard St.
VICTORIA B.C. V8V 1X4

RECEIVED
P15
JAN 28 1997
PROSPECTORS PROGRAM
MEMPR

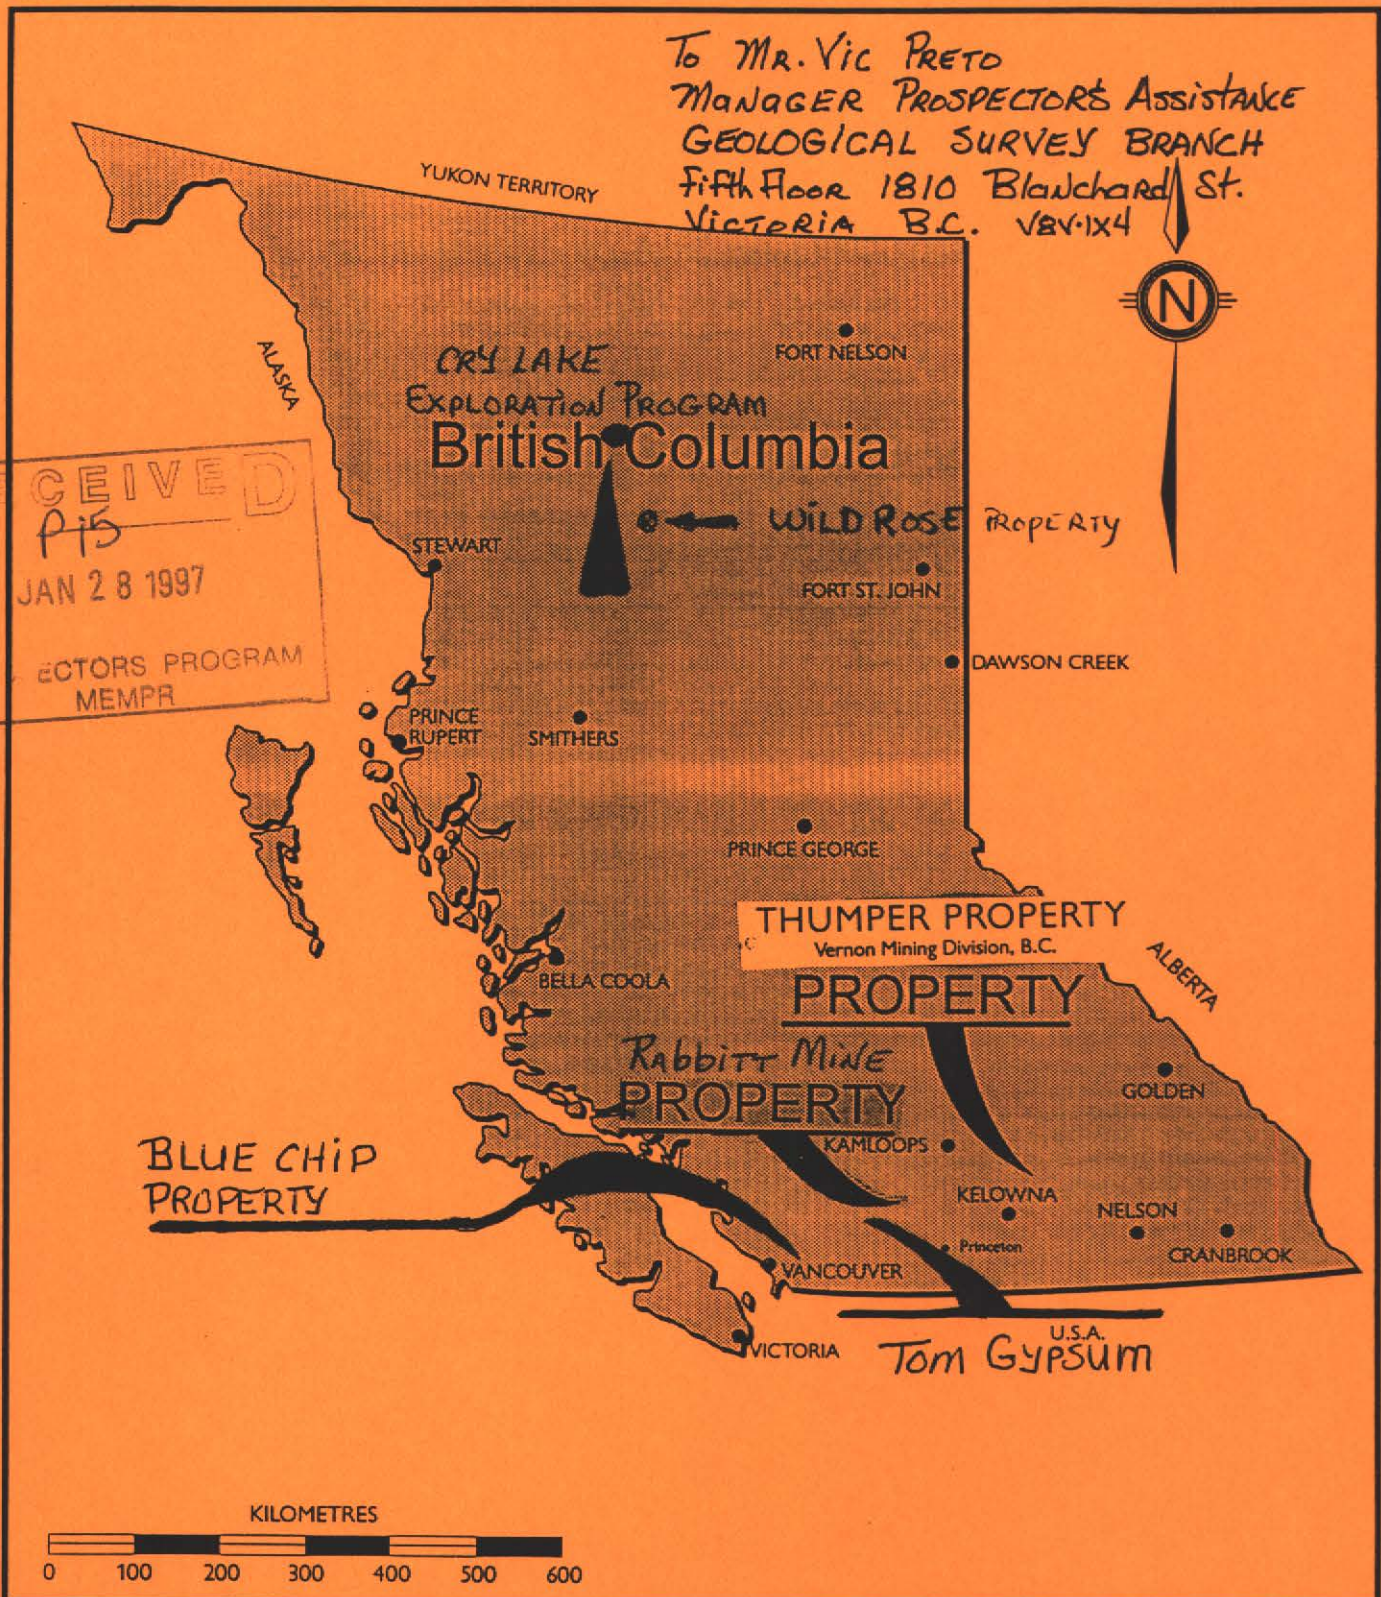

David Javorsky Prospector Grant

LOCATION MAP

1996 EXPLORATION

PROSPECTORS ASSISTANCE
PROGRAM
REFERENCE No. 96/97-P-15

**BRITISH COLUMBIA
PROSPECTORS ASSISTANCE PROGRAM
PROSPECTING REPORT FORM (continued)**

B. TECHNICAL REPORT

- * One technical report to be completed for each project area
- * Refer to Program Requirements/Regulations, section 15, 16 and 17
- * If work was performed on claims a copy of the applicable assessment report may be submitted in lieu of the supporting data (see section 16) required with this TECHNICAL REPORT

Name _____ Reference Number _____

LOCATION/COMMODITIES

Project Area (as listed in Part A.) Rabbit Mine Minfile No. if applicable 92 H - NE 14
Location of Project Area NTS 92 H - 10 W Lat 49° 33' N Long 120° 52' W
Description of Location and Access Tulameen River Road, Take bear Creek mine Road or From the north Lawless Creek Forestry Access Road to mine Road

Main Commodities Searched For Gold

Known Mineral Occurrences in Project Area Rabbit Mine

WORK PERFORMED

1. Conventional Prospecting (area) Yes and Sampling
2. Geological Mapping (hectares/scale) ReLogging Core, Sampling
3. Geochemical (type and no. of samples) _____
4. Geophysical (type and line km) _____
5. Physical Work (type and amount) _____
6. Drilling (no. holes, size, depth in m, total m) _____
7. Other (specify) Computer Mapping of Mineral Showing

SIGNIFICANT RESULTS (if any)

Commodities Gold Claim Name Gold Mountain, Gail Gold
Location (show on map) Lat _____ Long _____ Elevation _____
Best assay/sample type 0.7 Au/ton 1.5 meter; 0.476 Au/ton 3.5 feet

Description of mineralization, host rocks, anomalies
Quartz ledge
Every body calls it a vein however it is a vein system.

Supporting data must be submitted with this TECHNICAL REPORT.

Rabbitt Mine Project 1996

I have held the three claims that cover the Rabbitt Mine since 1978. After I shipped 196 tonnes of Quartz Flux to the Trail Smelter in 1999 I was able to option the ground for eleven years.

Quite a bit of work was done on the ground during the time it was optioned, however, I always felt the optioning company was more interested in flow through shares, promotion and such than they were in doing their geology.

August 4, 1996; The property was accessed and Camp was set up at Murphy Lakes 2 kms to the NW of the claim block. I was aided by Bobbie Javorsky who has graduated from the B.C. M of E, M & PR Advanced Prospecting School. Quite a bit of deadfall was laying across the road. Spent afternoon cutting.

August 5, 1996 Spent day cutting deadfall off Road and contracted to get it moved.

August 6, with help of Ed Ford's JD 550 dozer the cut logs were pushed to the side of the road.

August 7th accessed the old coreshack and started to sort out the core. The stacks were snowed over.

August 8th with help of Stan Bopray the core was moved to his dad's ranch in Princeton.

August 9th to 12th the core was relogged and Reblended.

The results of this reinterpretation and relogging of the core was sent to Vancouver to be plotted on AutioCad along with information on the veins position on the surface in relation to the drill holes and the vein underground.

The computer program AutioCad allows you to rotate your information and to look at it from all sides. This provided us information on

How close the drill holes came to intersecting the individual quartz vein that had previously carried ore values. This was important because there are some larger barren quartz veins close to the one that carries values. These large ~~values~~ veins seem to attract company geologist who are under pressure to quickly take money and go up and drill to obtain some assays to ~~produce~~ ~~with~~. As a result it was not surprising to find that 3 of the 50 old drill holes actually intersected the ore carrying vein.

I have to thank Geologist Marshal Smith and his computer for clearing me in that this type of program would produce these type of results. See the following drill plans.

Because so much work had been done with negative results the property had effectively been killed. However these drill plans show that most of this work had not drilled the mineralizing system. The following assay certificate shows the results of the splits taken from the old drill core to check previous work.

Notice it is necessary to check for metallics since this vein has produced coarse gold. There is usually as much gold in the minus 100 mesh material as there is in the over 100 mesh material, at the Rabbitt mine. Big Bunnies and Little Bunnies dollie says.

PREVIOUS DIAMOND DRILLING

Hole #	Bearing (deg)	Dip (deg)	Length (m)	Assay (Au opt)	Sample (m)
83-1	204	45	50.9	0.099	0.8
83-2	225	59	61.6		
83-3	316	47	33.7	0.232	0.9
83-3				1.645	1.8
83-4	122	52	45.7	0.285	1.5
83-5	156	46	31.1		
83-6	93	83	49.4		
86-1	122	43	36.9	0.210	0.8
86-2	122	48	44.5	0.285	1.1
86-3	148	45	39.6	0.572	2.0
86-4	148	55	44.2	1.173	0.8
86-7	277	45	23.2	0.228	2.4
86-10	316	58	25.6	0.238	3.0
86-12	278	45	44.5	0.381	1.9
86-23	280	55	67.1	0.192	0.4
86-25	260	45	43.0	0.312	0.9
86-27	270	45	32.3	1.159	0.5

Hole #	Sediments	Location	Comments
83-1	Yes	Footwall	Did not penetrate footwall of vein, drilled in footwall of zone.
83-2	Yes	Footwall	Drilled south of zone. Did not intersect contact or quartz vein
83-3	Yes	Footwall	Intersected zone from footwall side, assayed 0.26 oz. gold/ton across 5.75'.
83-4	No	Hanging wall	Drilled south of zone. Did not intersect contact or quartz vein.
83-5	No	Hanging wall	Drilled south of zone.
83-6	Yes	Hanging wall	Drilled north of main shoot between both shoots.
86-1	No	Hanging wall	Drilled south of zone. Did not intersect contact or quartz vein.
86-2	No	Hanging wall	Drilled south of zone. Did not intersect contact or quartz vein.
86-3	No	Hanging wall	Drilled south of zone. Did not intersect contact or quartz vein.
86-4	No	Hanging wall	Drilled south of zone. Did not intersect contact or quartz vein.
86-7	No	Hanging wall	Drilled to west from hanging wall.
86-10	Yes	Footwall	Intersected similar zone as in 83-3 and terminated in upper adit.
86-12	Yes	Footwall	Drilled too far to the south to intersect the shoot.
86-23	Yes	Hanging wall	Drilled to west from hanging wall.
86-25	Yes	Footwall	Drilled to west from hanging wall.
86-27	Yes	Footwall	Drilled to west from hanging wall.

ROSSBACHER LABORATORY LTD.

CERTIFICATE OF ANALYSIS

To : Marshall Smith Consulting Ltd.

2225 Springer Ave., Burnaby,
British Columbia, Can. V5B 3N1
Ph:(604)299-6910 Fax:299-6252

Certificate: 94291 G
Invoice: 50369


Project: Javorski - Rabbit Mine
Type of Analysis: Geochemical

File Name: MSC94291
Page No.: 1


PRE FIX	SAMPLE NAME	Geoch. PPB AU	oz/t Au FA	oz/t Au AR*)	oz/t Au AR*)	
A1	548858	640	0.022			83-1 Brown dacite 27.5 - 38
A1	548859	5				83-2 " 18 - 28
A1	548860	5				83-2 grey dacite 104 - 114
A1	548861	5				83-2 " 114 - 122.5
A1	548862	170	0.010 (**)			86-2 vesplet quartz 83.20 ppb
A1	548863	1300	0.004	0.003	0.020	86-3 vesplet 71-82
A1	548864	9500	0.281 (**)	0.240	0.236	86-3 " 82-84
A1	548865	16500	0.782 (**)	0.600	0.720	86-3 " 84-85.5
A1	548866	1120	0.003	0.210	0.001	86-3 " 74-79
A1	548867	20				86-3 grey dacite 85.5-88
A1	548868	10				86-4 " 100.3-103
A1	548869	40				86-10 grey dacite 51.6-61.6
A1	548870	150	0.008 (**)			86-10 " 61.6-70.5
A1	548871	5				86-20 flower porph 90-95
A1	548872	2540				83-3 yellow dacite II 49-54.5
A1	548873	30				83-3 footwall of V/ in II.

*) Aqua Regia digest / AA finish , done on -100 mesh fraction.
**) Metallics assay results. Samples screened to -100 mesh .

83-3 74.0 - 85.5 11.5 feet of 0.258
82.0 - 85.5 3.5 feet of .4765


CERTIFIED BY: 

Rabbitt Mine & Nearby Diamond Drilling 1983-1987

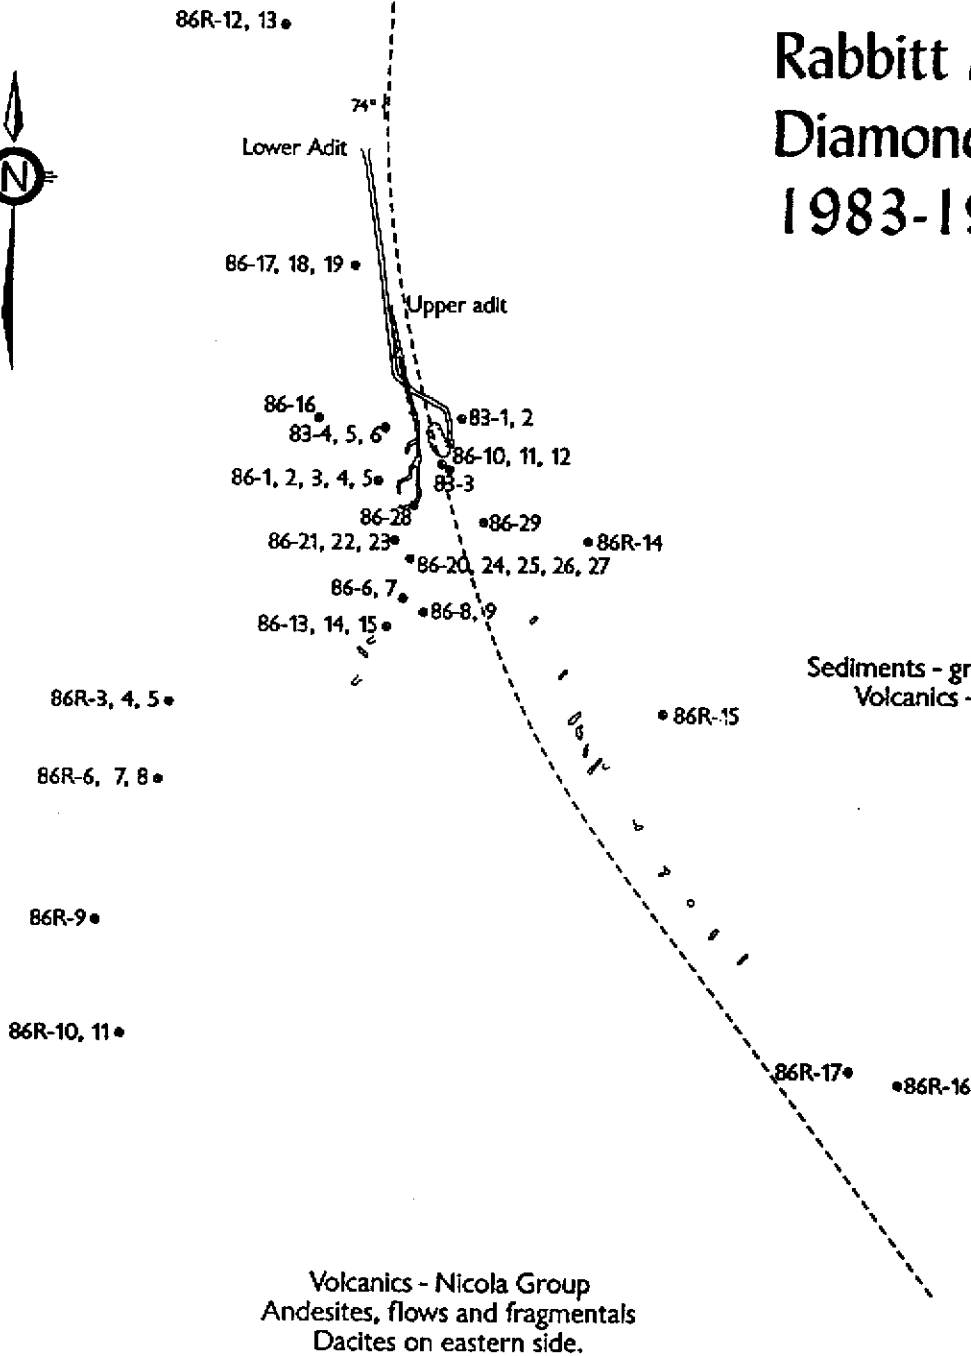

Sediments - graphitic calc-arenites & cherts
Volcanics - minor flows of andesite

Volcanics - Nicola Group
Andesites, flows and fragmentals
Dacites on eastern side.

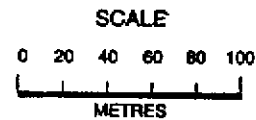

LEGEND

- 86R-2 Diamond Drill Hole Pin & Number
- Approximate Geological Contact
- U Gold Bearing Vein in Adit
- U Adit
- T Trench
- O Stope Hole



• 86R-2

86R-1•

Drilling from L. Christensen, 1987
Adit plan from C.E. Cleveland, 1946



David Javorsky Prospector Grant	
DIAMOND DRILL PLAN RABBITT PROPERTY Similkameen Mining Division, B.C.	
F. Marshall Smith F.G.A.C.	
DATE: August,	SCALE: AS SHOWN
DRAWN BY: FMS	FIGURE NO.:

Rabbitt Mine area Diamond Drilling 1983-1987

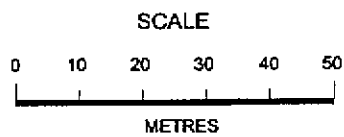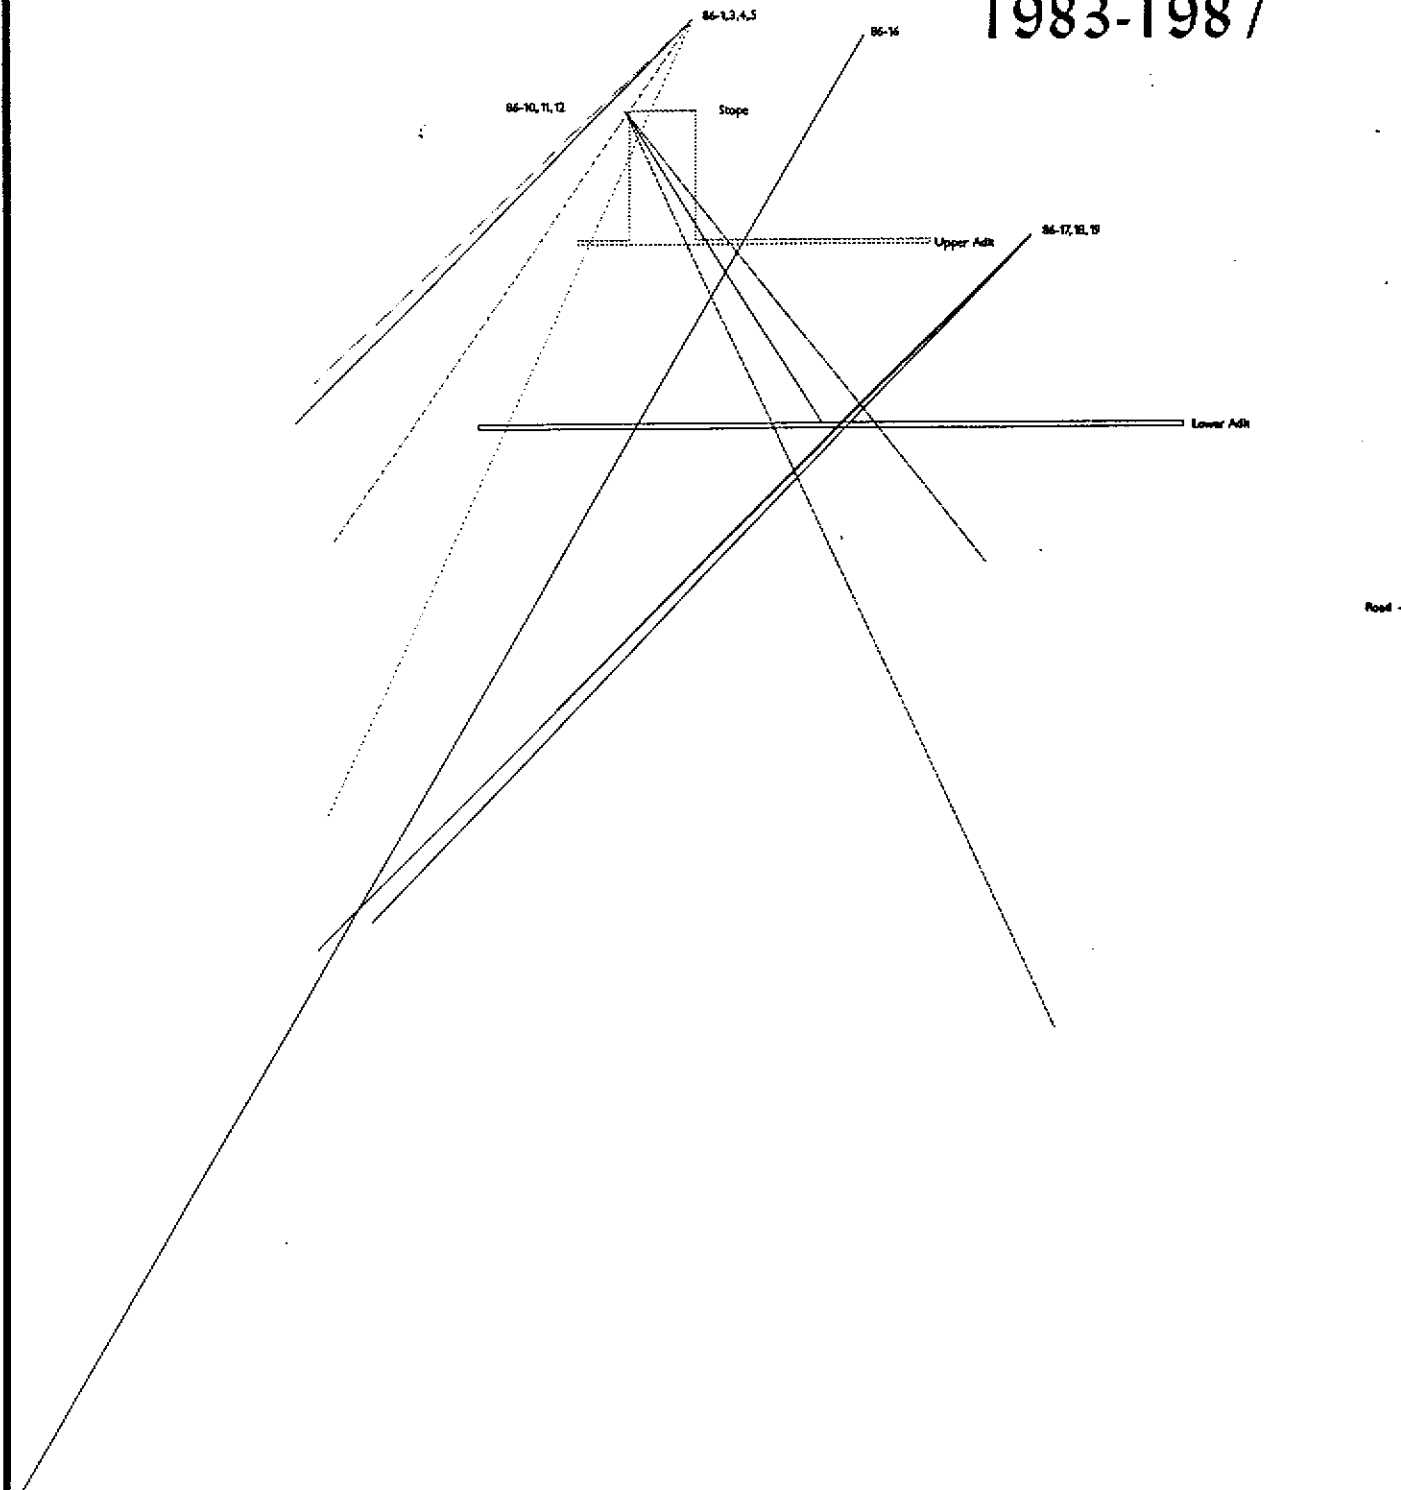




Projection looking westerly normal to trace of Rabbitt Vein

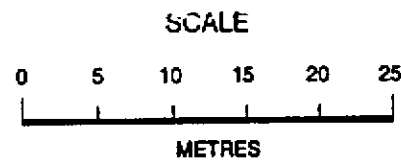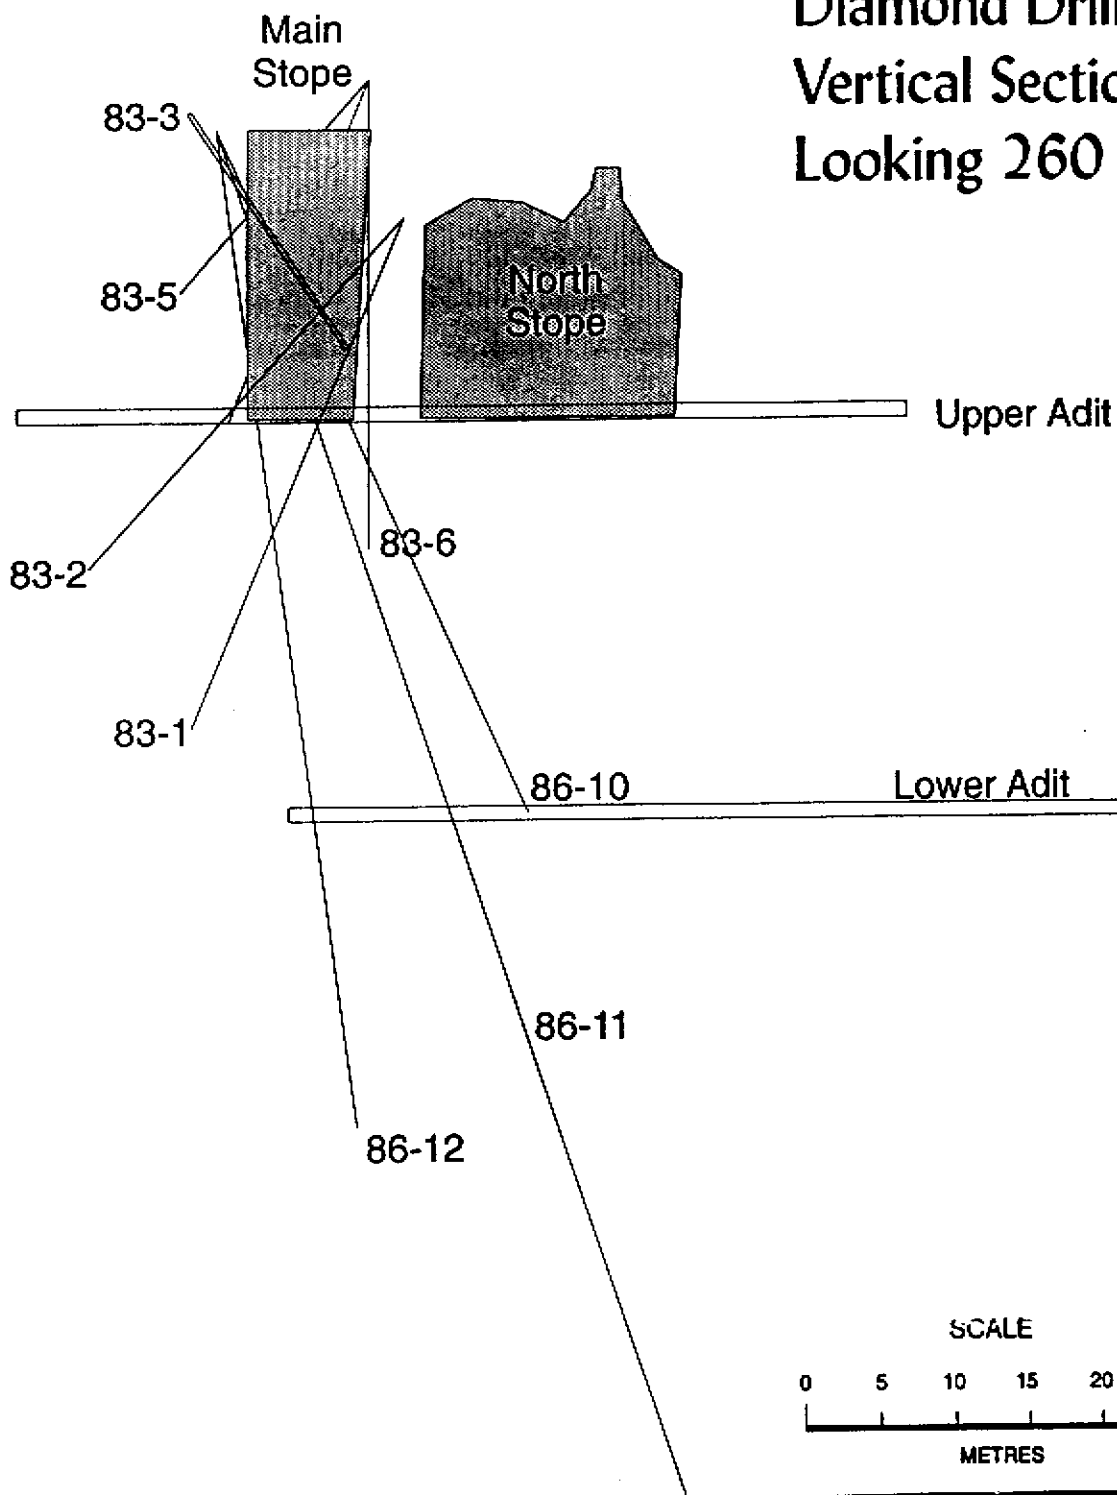Rabbitt Mine area Diamond Drilling Vertical Section Looking 260 Az




LEGEND


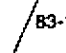

-  Outline of adit
-  83-1 Diamond Drill Hole and number
-  Approximate outline of stoped vein

David Javorsky Prospector Grant	
LOCAL COMPOSITE SECTION	
RABBITT PROPERTY Similkameen Mining Division, B.C.	
F. Marshall Smith F.G.A.C.	
DATE: August,	SCALE: AS SHOWN
DRAWN BY: FMS	FIGURE NO.:

Rabbitt Mine area Diamond Drilling 1983-1987


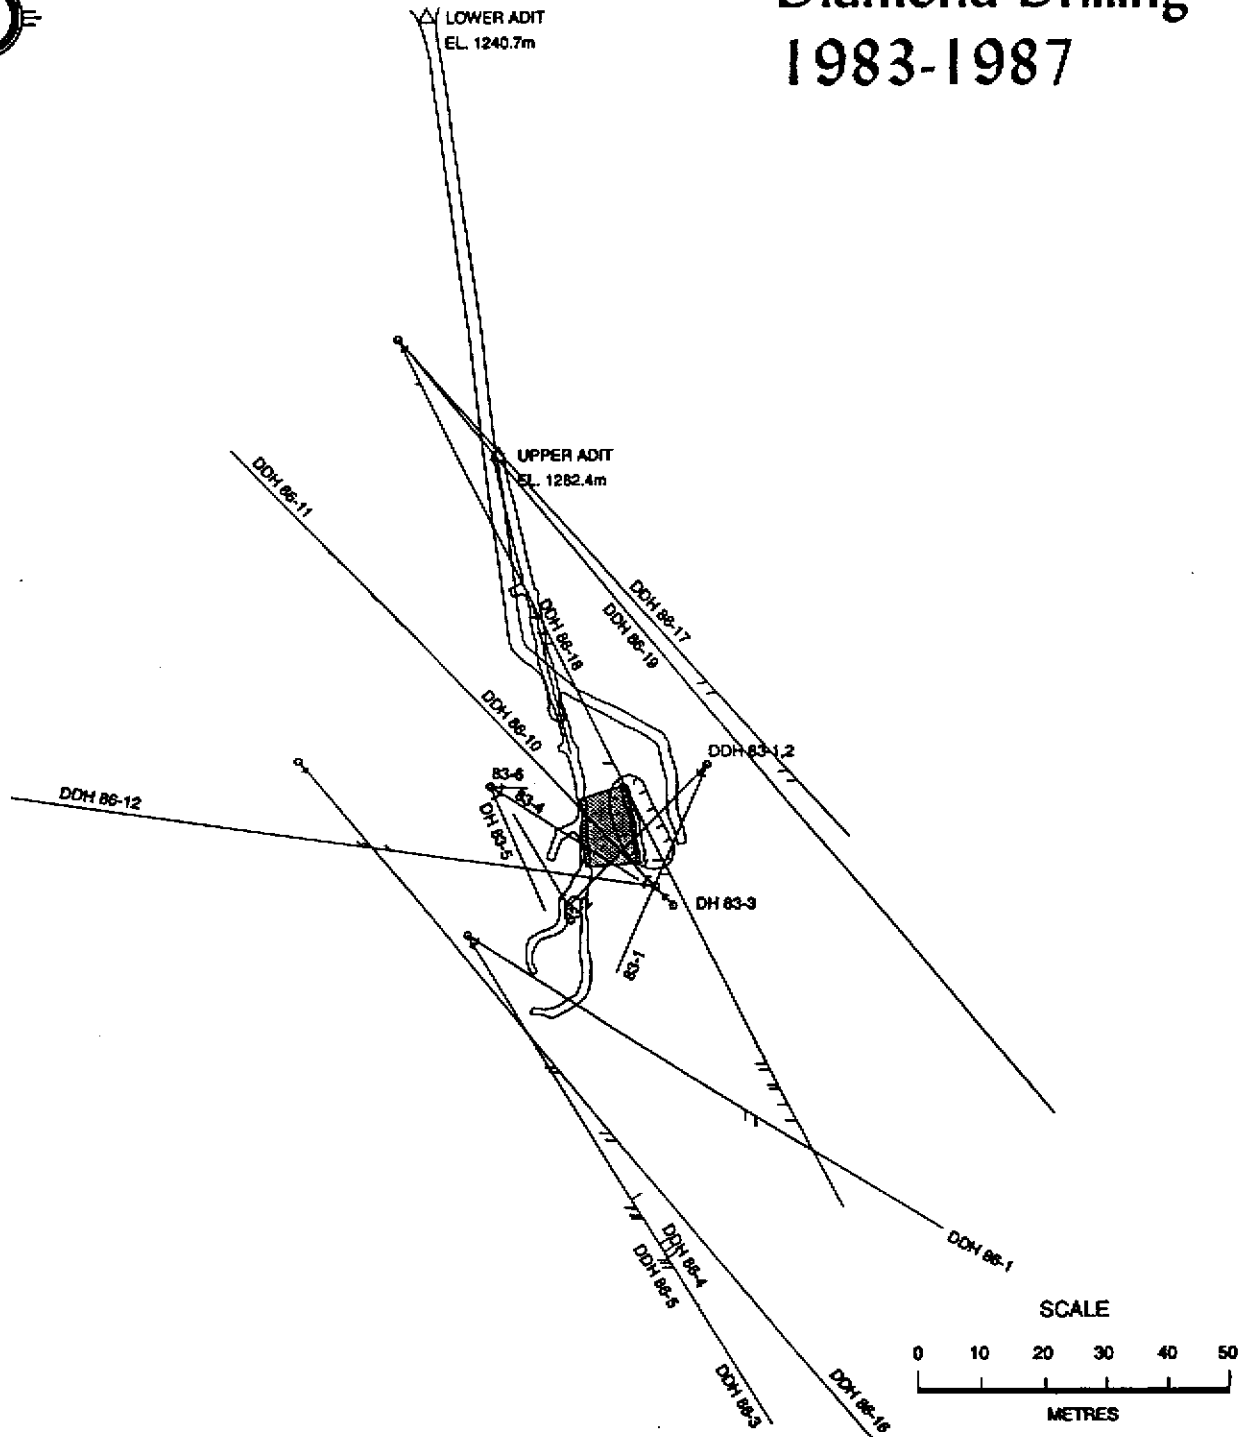


LEGEND




-  Outline of adit
-  83-1 Diamond Drill Hole and number
-  Approximate outline of stoped vein

David Javorsky Prospector Grant	
LOCAL DRILL PLAN	
RABBITT PROPERTY	
Similkameen Mining Division, B.C.	
F. Marshall Smith F.G.A.C.	
DATE: August,	SCALE: AS SHOWN
DRAWN BY: FMS	FIGURE NO.:

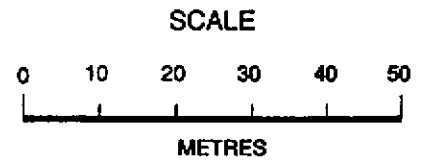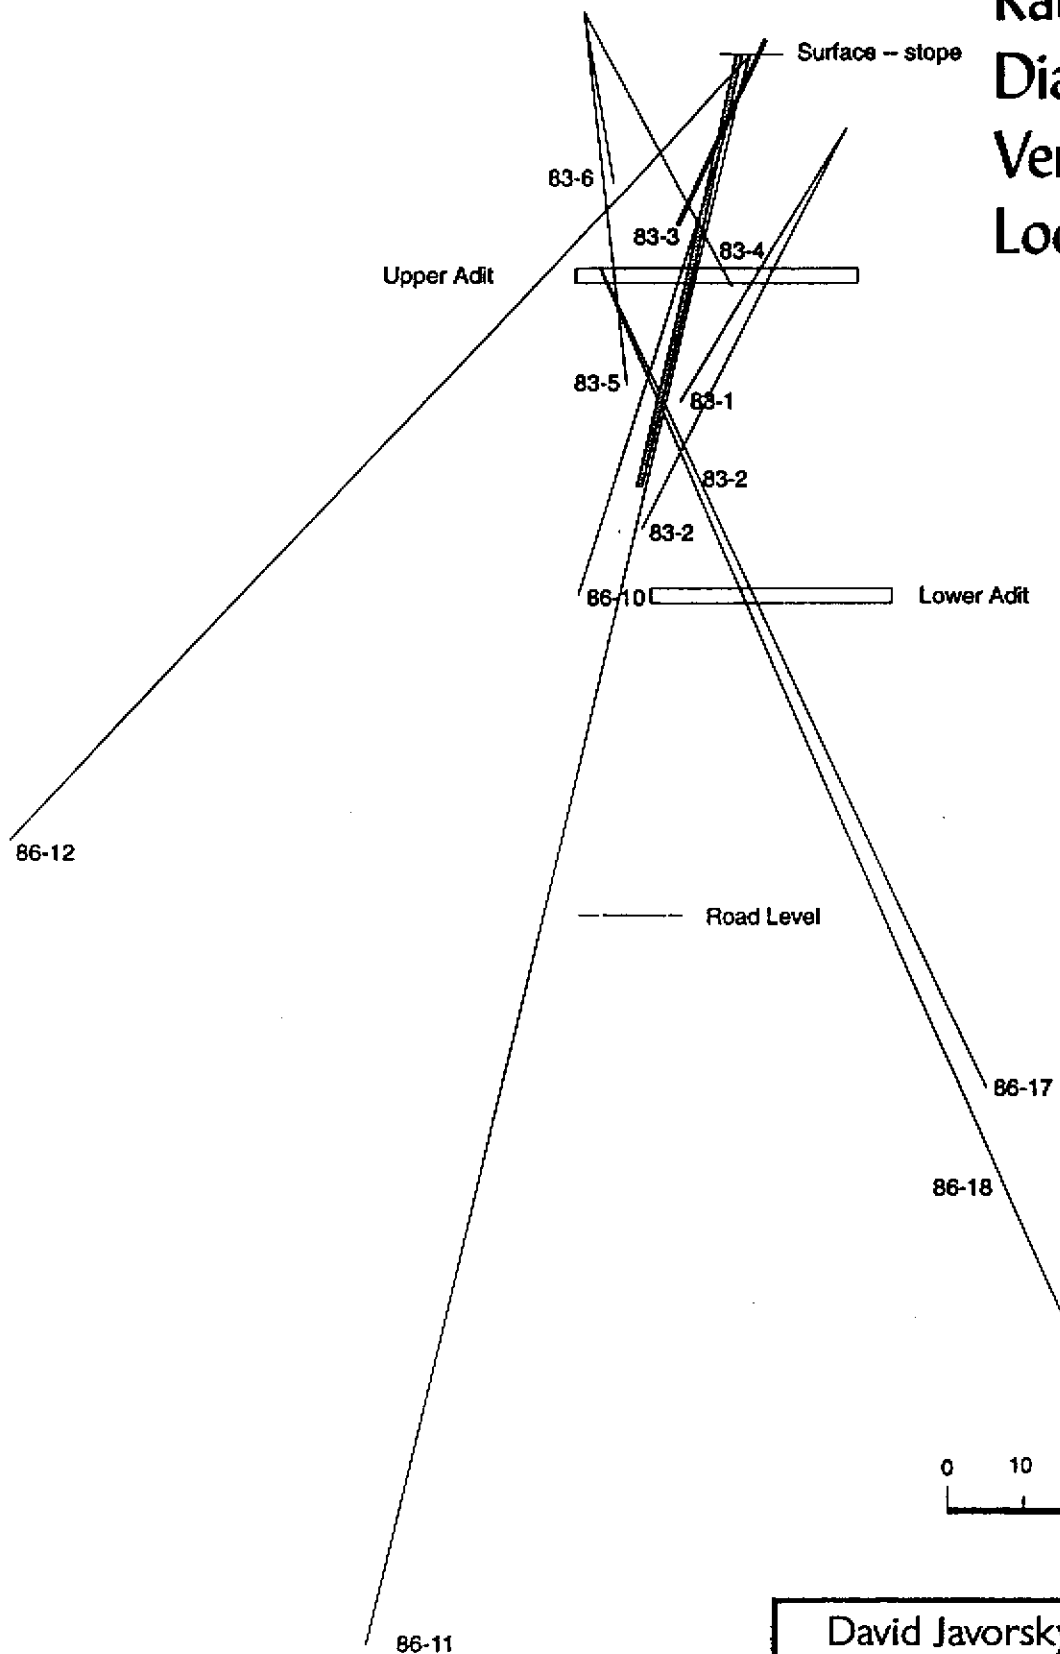Rabbitt Mine area Diamond Drilling Vertical Section Looking 350 Az



LEGEND

-  Outline of adit
-  Diamond Drill Hole and number
-  Approximate outline of stoped vein

David Javorsky Prospector Grant

LOCAL COMPOSITE SECTION

RABBITT PROPERTY

Similkameen Mining Division, B.C.

F. Marshall Smith F.G.A.C.


DATE: August,

SCALE: AS SHOWN


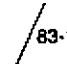

DRAWN BY: FMS

FIGURE NO.:

Rabbitt Mine area Diamond Drilling Enlargement



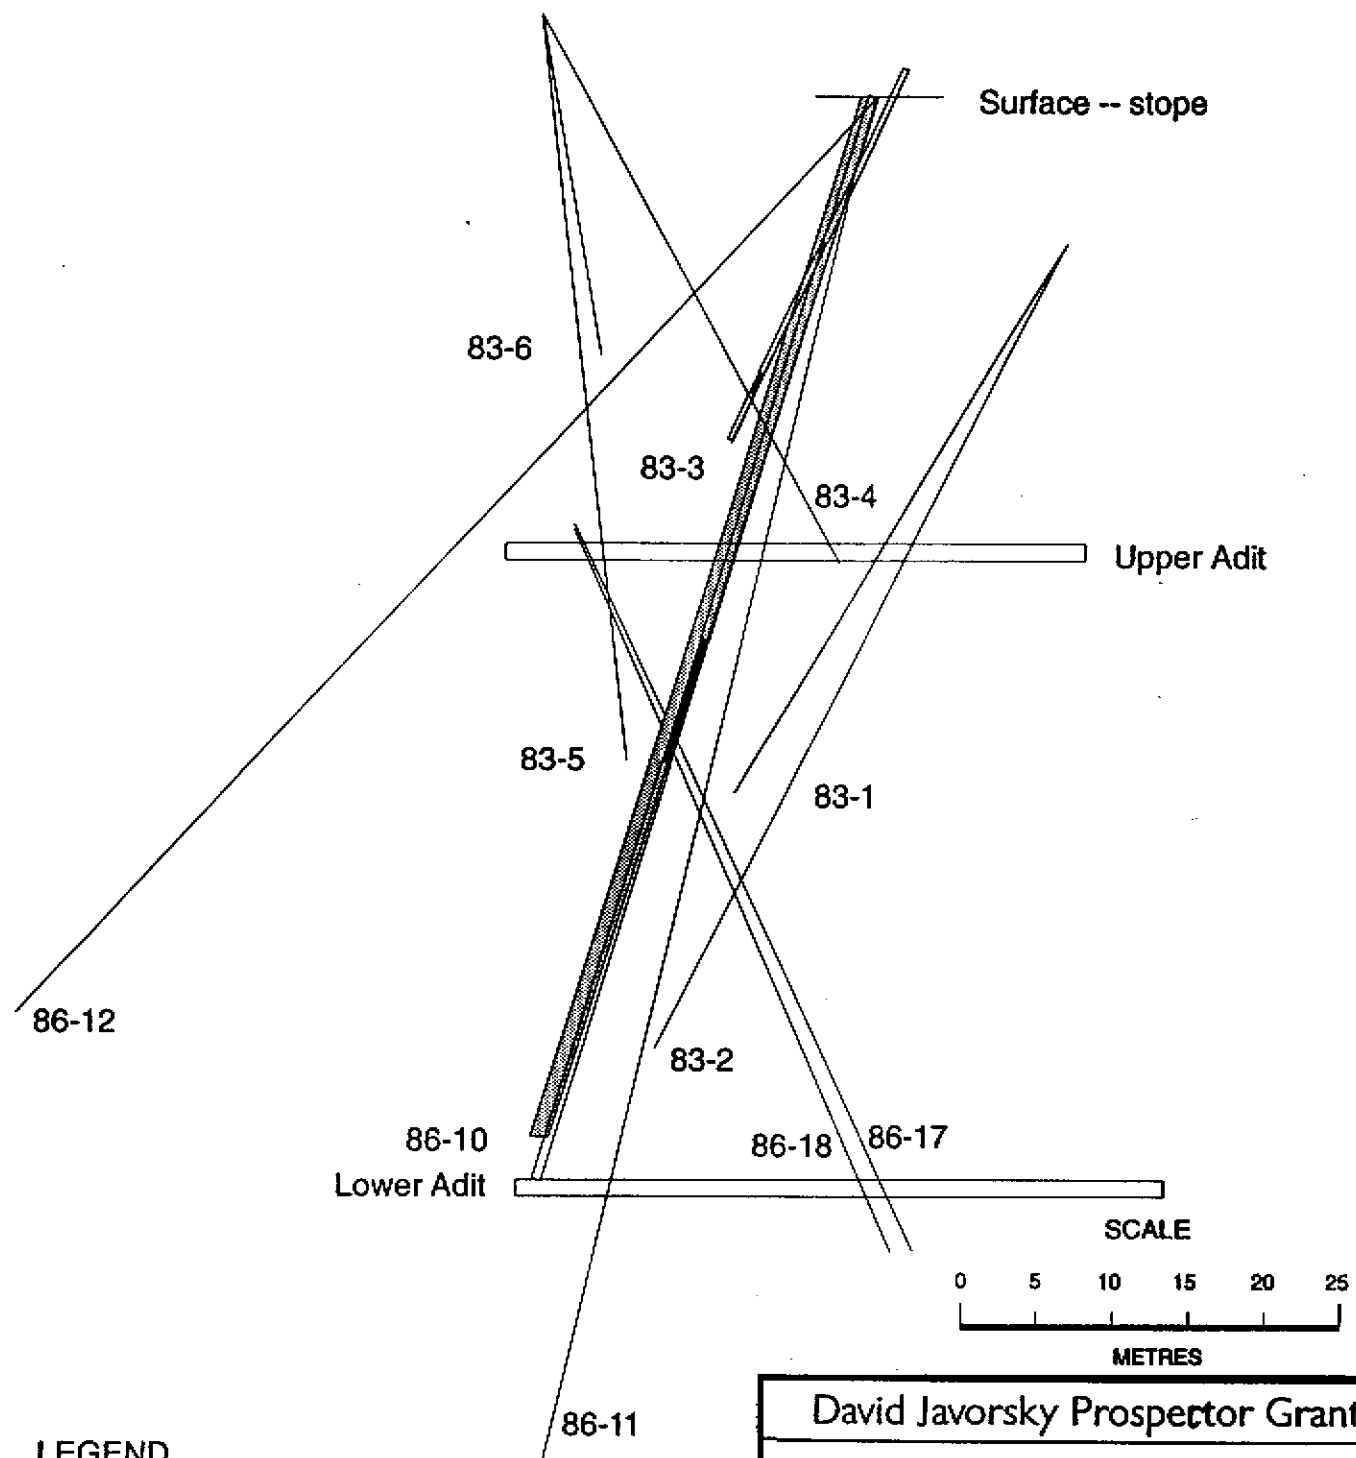


LEGEND


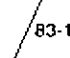

-  Outline of adit
-  83-1 Diamond Drill Hole and number
-  Approximate outline of stoped vein

David Javorsky Prospector Grant	
LOCAL COMPOSITE SECTION	
RABBITT PROPERTY	
<small>Similkameen Mining Division, B.C.</small>	
F. Marshall Smith F.G.A.C.	
DATE: August,	SCALE: AS SHOWN
DRAWN BY: FMS	FIGURE NO.:

Rabbitt Mine area Diamond Drilling 1983-1987 Holes near mined shoots

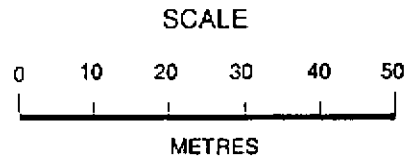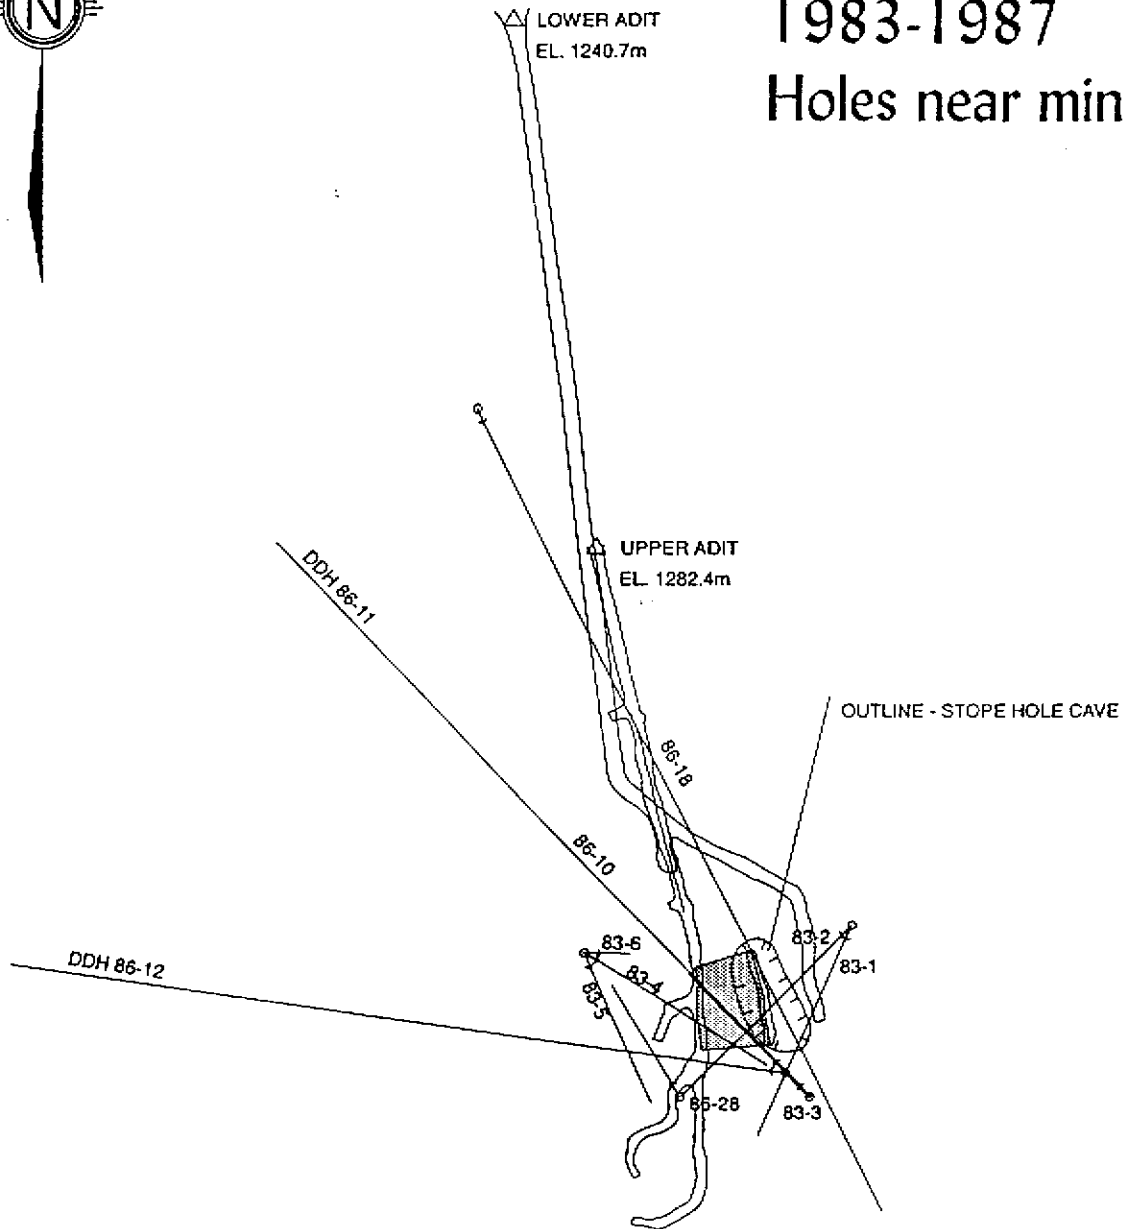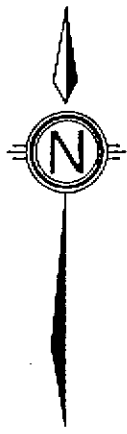

LEGEND

-  Outline of adit
-  83-1 Diamond Drill Hole and number
-  Approximate outline of stoped vein

David Javorsky Prospector Grant

LOCAL DRILL PLAN

RABBITT PROPERTY

Similkameen Mining Division, B.C.

F. Marshall Smith F.G.A.C.

DATE: August,

SCALE: AS SHOWN

DRAWN BY: FMS

FIGURE NO.:

Area around Rabbit Mine -

It is possible that some of the dikes or flows that are associated with the gold bearing quartz vein may carry values themselves.

Two dikes in the area were sampled with no success. One near a quartz vein on the H: H claims the other on the Rambler Crown Grant. See location map that follows.

A very unusual small white flower grows on Grasshopper Mountain and to the south on Olivine Mountain. This flower will absorb gold and platinum through its roots. It is possible that this plant is similar to House Tails that secrete a cyanide solution into the rocks around its roots and then absorb the digested precious metals.

People who are selling cancer cures are always picking these plants off the south side of Grasshopper Mountain where they grow on the Dunite. They claim the platinum in the plant cures cancer and sell tea made from these plants to people suffering from cancer.

A paper lunch bag was filled with the total plant; flowers stems and roots. The material was ashed at low temperature. The ashes were digested with aqua regia. The plant assayed 0.03 ounce per ton gold. This is very high, there are some heap leach gold operations making a profit on rock that assays 0.03 ounce per ton gold.


Question. if tea containing platinum is suppose to help cancer patients, will tea containing gold be of help to some one who has arthritis, so they don't have to take gold shots.

SAMPLE LOCATION MAP

H-1, Sample of intrusive rock that is associated with Quartz veins on H & H claim.

D.R.-#6 Sample of intrusive Rock that is associated with Quartz Vein on Rambler Claim.

Plant Sample of Plant, Ashed, This plant grows near Basic Rock, white variety assays

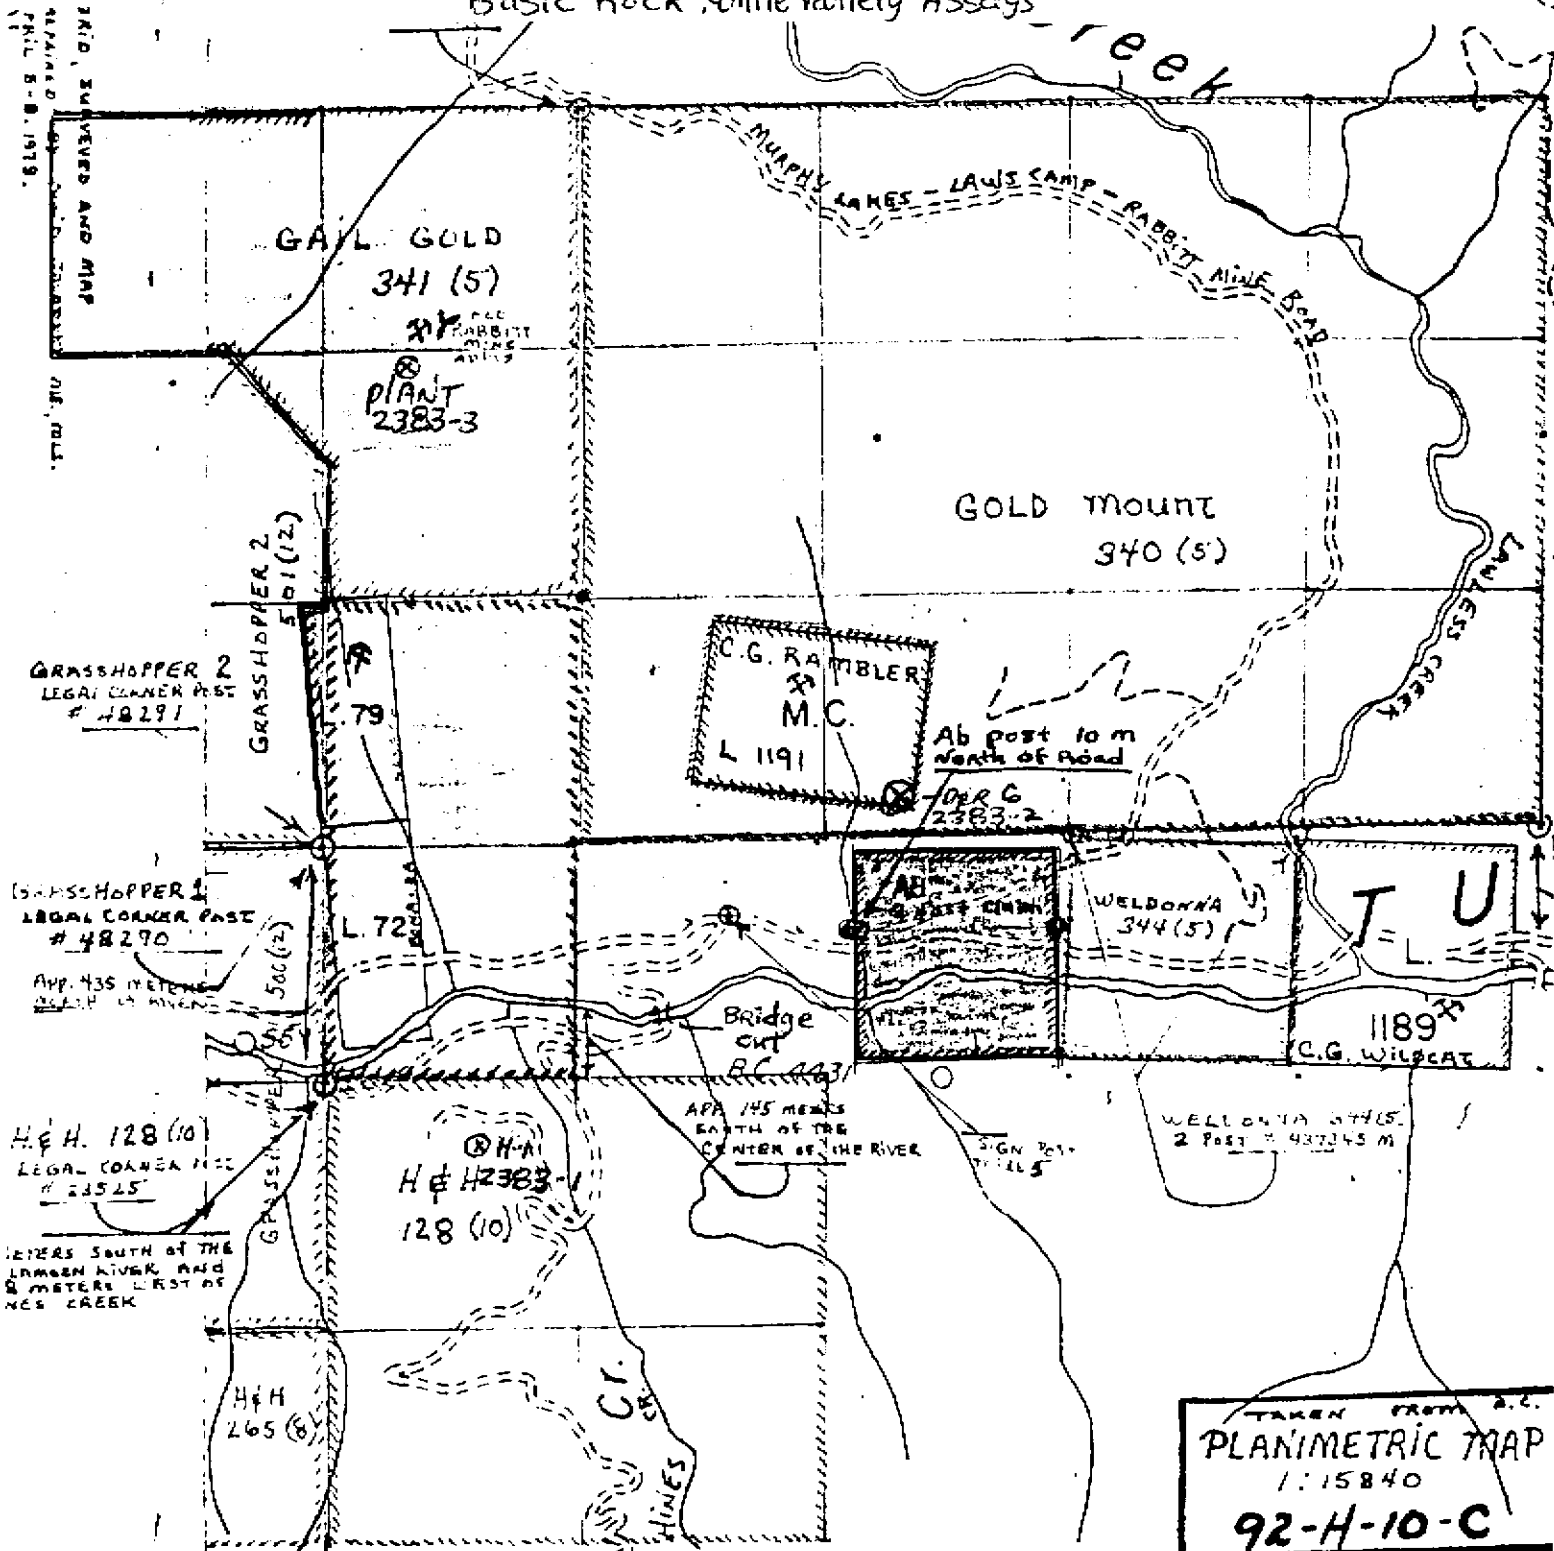

quanta trace laboratories inc.

#401-3700 Gilmore Way, Burnaby, B.C., Canada V5G 4M1

Tel: (604) 438-5226

ANALYSIS OF GEOLOGICAL SAMPLES

To: Mr. D. Javorsky
1614 - 675 W. Hastings Street
Vancouver, B. C.
V6B 4W3

Workorder: 2383

Re: Chemical Analysis of Rock Samples

Sample type	Rock	Rock	Rock	Rock	Plant Ash
Identification	H-1	H-1	D&R #6	D&R #6	Plants
Lab Reference #	2383-001	2383-001	2383-002	2383-002	2383-003
Analyzed by Plasma Emission Spectroscopy (ICAP)					
Method used	laqua regia	alkaline	laqua regia	alkaline	laqua regia
	soluble	fusion	soluble	fusion	soluble
Amount analysed	2.01 g	0.101 g	2.01 g	0.100 g	3.33 g
Trace Elements					
Arsenic As	40	-	40	-	< 20
Boron B	4.	-	3.	-	173
Beryllium Be	0.5	-	0.10	-	< 0.06
Bismuth Bi	< 20	-	< 20	-	< 10
Cadmium Cd	< 0.5	-	< 0.5	-	0.4
Cobalt Co	14.	-	9.	-	40
Chromium Cr	147.	-	60.7	-	37.2
Copper Cu	91.	-	12.	-	15
Mercury Hg	< 10.	-	< 10.	-	< 6
Molybdenum Mo	5.	-	3.	-	< 2
Nickel Ni	26.	-	9.	-	524
Lead Pb	62.	-	10.	-	7.9
Antimony Sb	< 10.	-	< 10.	-	< 6
Selenium Se	< 10.	-	< 10.	-	< 6
Thorium Th	< 5.	-	< 5.	-	< 3
Uranium U	< 30	-	< 30	-	< 20
Vanadium V	21.4	-	29.3	-	25.5
Zinc Zn	36.	-	45.	-	58
Results in	ug/g		ug/g		ug/g
Precious Metals - Fire Assay					
Silver Ag	0.05	-	0.05	-	< 0.01
Gold Au	0.003	-	0.005	-	0.03
Palladium Pd	< 0.001	-	< 0.001	-	< 0.04
Platinum Pt	0.002	-	0.002	-	< 0.09
Rhodium Rh	< 0.001	-	< 0.001	-	< 0.09
Results in	oz/T		oz/T		oz/T

quanta trace laboratories inc.

#401-3700 Gilmore Way, Burnaby, B.C., Canada V5G 4M1

Tel: (604) 438-5226

To: Mr. D. Javorsky

W/O: 2383 Page 2

Sample type		Rock	Rock	Rock	Rock	Plant Ash
Identification		H-1	H-1	D&R #6	D&R #6	Plants
Lab Reference #		2383-001	2383-001	2383-002	2383-002	2383-003
Major Elements						
Aluminum	Al	13800	38400	5360	92100	2830
Barium	Ba	422.	1390	75.	994	96.9
Calcium	Ca	23100	20800	19200	19000	9130
Iron	Fe	22900	24400	22200	23400	12600
Potassium	K	6800	18000	3000	49600	7900
Lithium	Li	< 100	-	< 100	-	< 6.
Magnesium	Mg	10400	12000	7800	8100	98100
Manganese	Mn	871.	789.	428.	406	803
Sodium	Na	< 100	3000	500	38200	2680
Phosphorus	P	1000	900	1400	1000	3140
Silicon	Si	1720	1366000	1050	1281000	1660
Strontium	Sr	66.	74.	100.	803	50.5
Titanium	Ti	344.	5690	58.	4680	129
Zirconium	Zr	< 10.	100	< 10.	30	1.
Results in		ug/g	ug/g	ug/g	ug/g	ug/g
Majors as Oxides						
Silicon	% SiO ₂	-	78.4	-	80.1	-
Aluminum	% Al ₂ O ₃	-	7.26	-	17.4	-
Iron	% Fe ₂ O ₃	-	3.48	-	3.35	-
Calcium	% CaO	-	2.91	-	2.70	-
Magnesium	% MgO	-	2.00	-	1.30	-
Sodium	% Na ₂ O	-	0.41	-	5.15	-
Potassium	% K ₂ O	-	2.20	-	5.98	-
Barium	% BaO	-	0.155	-	0.111	-
Manganese	% MnO	-	0.102	-	0.052	-
Phosphorus	% P ₂ O ₅	-	0.20	-	0.30	-
Strontium	% SrO	-	0.009	-	0.095	-
Titanium	% TiO ₂	-	0.95	-	0.78	-
Zirconium	% ZrO ₂	-	0.010	-	0.004	-
Loss on Ignition		-	1.14	-	3.16	-
Results in			%		%	%
Total oxides			99.1		100.2	

Analyst: SKD

**BRITISH COLUMBIA
PROSPECTORS ASSISTANCE PROGRAM
PROSPECTING REPORT FORM (continued)**

B. TECHNICAL REPORT

- One technical report to be completed for each project area.
- Refer to Program Requirements/Regulations, section 15, 16 and 17.
- If work was performed on claims a copy of the applicable assessment report may be submitted in lieu of the supporting data (see section 16) required with this TECHNICAL REPORT.

Name Dave JAVORSKY Reference Number 96-P-15

LOCATION/COMMODITIES

Project Area (as listed in Part A) Tom MINFILE No. if applicable 92i NW054
Location of Project Area NTS 92i-11w Lat 54° 34' N Long 121° 18' W
Description of Location and Access South of Ashcroft BC along the highway.

Main Commodities Searched For Gold - Gypsum

Known Mineral Occurrences in Project Area Gypsum Tom, Spatsum

WORK PERFORMED

1. Conventional Prospecting (area) Sampling
2. Geological Mapping (hectares/scale) _____
3. Geochemical (type and no. of samples) Sampling
4. Geophysical (type and line km) _____
5. Physical Work (type and amount) _____
6. Drilling (no., holes, size, depth in m, total m) _____
7. Other (specify) _____

SIGNIFICANT RESULTS

Commodities Gypsum Claim Name Tom
Location (show on map) Lat _____ Long _____ Elevation _____
Best assay/sample type 86% Gypsum

Description of mineralization, host rocks, anomalies _____
Upper Expression of a Epithermal Alteration Zone
Kaolene Clay and Gypsum.
Results to much chloride in the gypsum to use in
Wall board or cement.

Supporting data must be submitted with this TECHNICAL REPORT
Information on this form is confidential for one year from the date of receipt subject to the provisions of the Freedom of Information Act.

Tom Gypsum Project

I first staked the Tom Gypsum showing as a Epithermal Gold prospect. Although the showing was a high top to a epithermal system, I was unable to find any gold.

So I figured I needed to get lower in the system, perhaps I could move the top 100 feet or so off the deposit and then look for gold.

Is there a market for Gypsum? Easy way, to get ride of it is to sell it. So I started making the rounds to the Gypsum users.

Domtar Gypsum of Surrey B.C., and WestRock Industries of Vancouver Both make wall board from Gypsum.

I submitted samples to Domtar and the samples were assayed in the company labs.

This letter from Domtar's Manufacturing Engineer, Peter Sutton explains the problem: To Much CHLORIDES.

I sent samples to Lafarge Canada at Kamloops where they produce cement. Again the clorides keep the cement from harding. No use to them.

Two days were spent on the Tom Gypsum showing, by Dollie Javorstky and myself. 24 July and 25 July 1996.

Domtar Gypsum

February 20, 1996

Mr. Dave Javorsky
P.O. Box 806
Stewart, B.C. V07 1W0

SUBJECT: GYPSUM ROCK SAMPLES


Dear Mr. Javorsky

We have recently completed an analysis of the gypsum rock samples which you supplied to us. As you may recall, we labelled the specimen from the smaller surface deposit as "Sample 1". The greyish specimen from the larger deposit was labelled "Sample 2". The results of the analysis were as follows:

Specimen	Measured Purity	Acceptable Min.	Measured Chlorides	Acceptable Max.
Sample 1	86 %	80 %	>30 oz/ton	2.5 oz/ton
Sample 2	39 %	80 %	>30 oz/ton	2.5 oz/ton

The chlorides tests were halted prematurely because they were well beyond the acceptable maximum. Although these samples are unsuitable for our purposes, we thank you for your interest. Best of luck !

Sincerely,

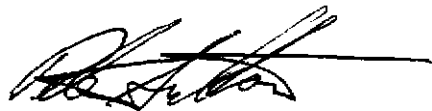


Peter Sutton
Manufacturing Engineer

— PICTOGRAPHIC REPORT ON —
— STANDARD MINING AND MILLING CO. LTD. —
— GYPSUM DEPOSITS AT SPATSUM. B.C. —

— BY —
R. A. BROOKE
 227 VANCOUVER ST. VANCOUVER B.C.

— SKETCH VIEW OF —
— STANDARD MINING AND MILLING CO. LTD. —
— PROPOSED PLAN OF OPERATION. —

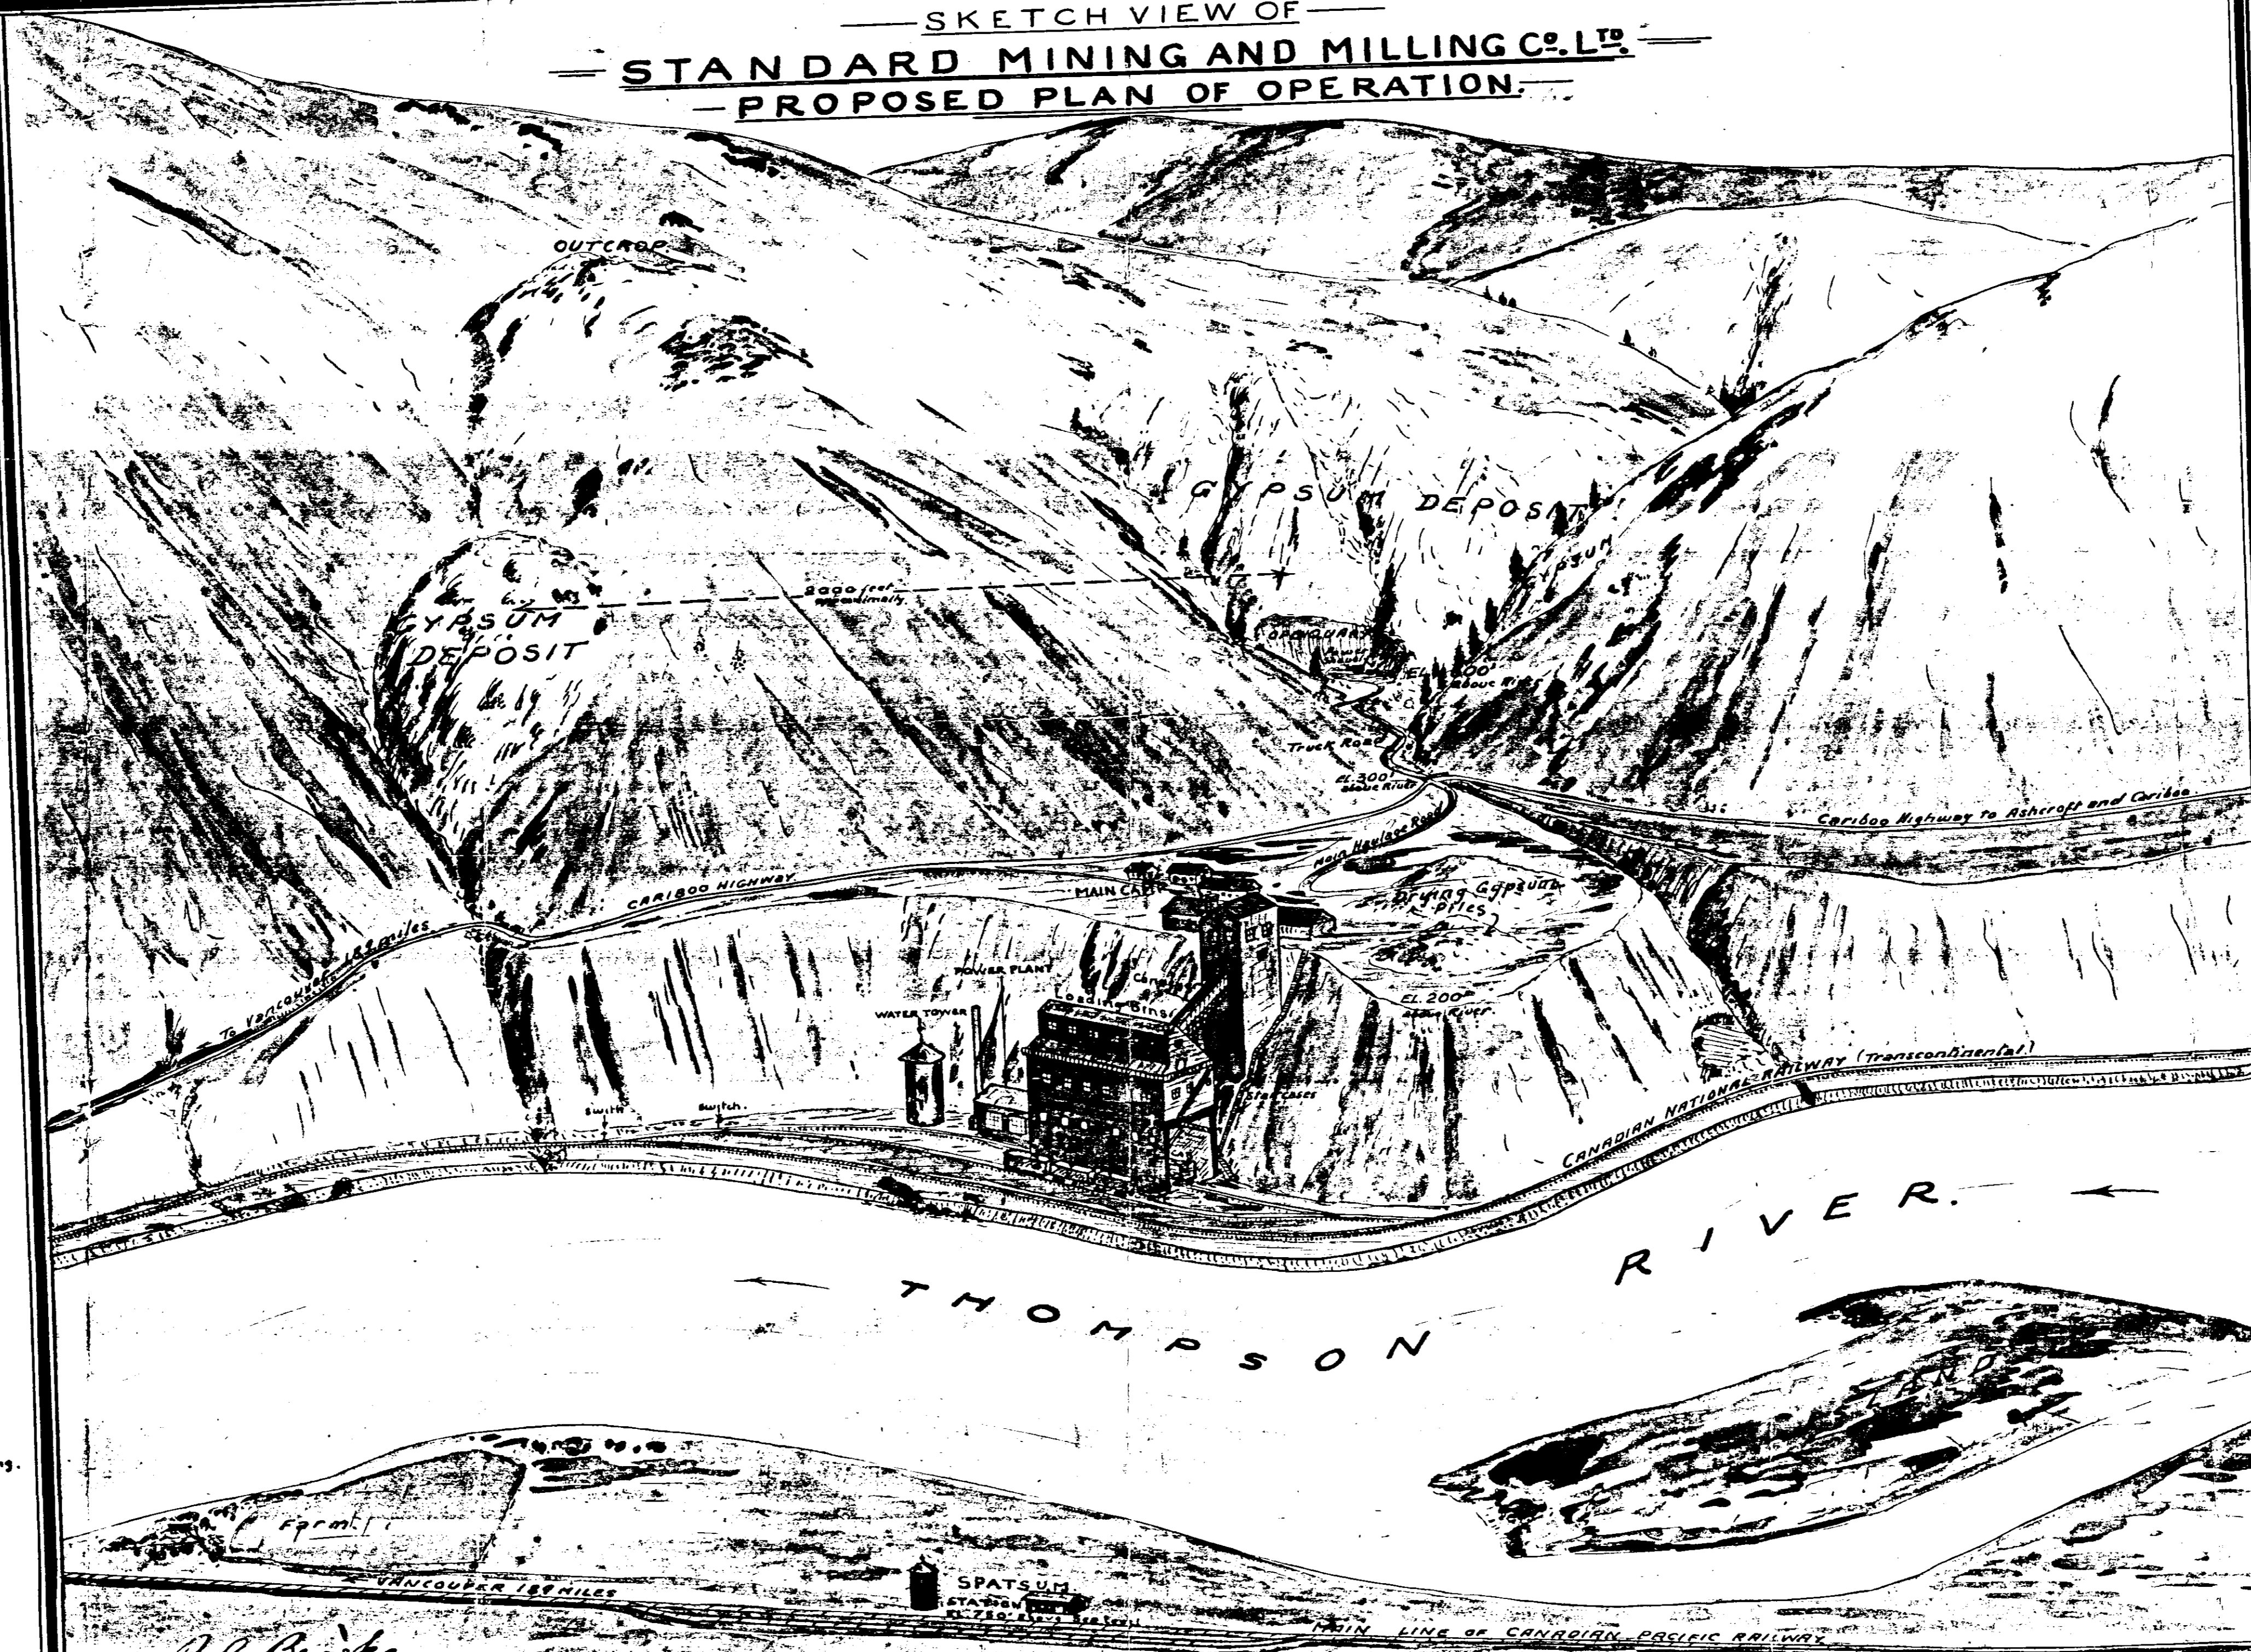


SUMMARY INFORMATION.

LOCATION-TRANSPORTATION.

The Spatsum Gypsum Deposits controlled by **THE STANDARD MINING AND MILLING CO. LTD.** 503, Randall Bldg. Vancouver.

are located on the west bank of the Thompson River opposite the C.P.R. station of Spatsum, 183 miles from the all year around Open Port of Vancouver B.C. The Transportation facilities are ideal. The Canadian National Railway Main Transcontinental line follows the base of property where a spur track and siding can be installed right on the property providing direct rail transportation East or west. The Cariboo Highway also crosses the property and provides an easy mean of access to the property by truck, motor car and a bus service.

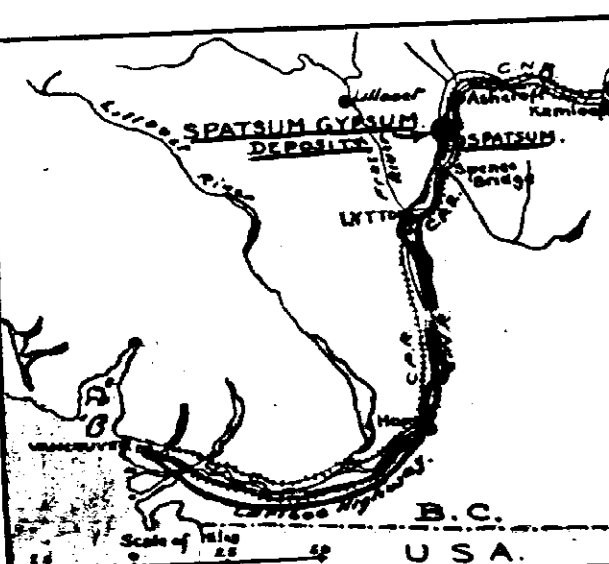

GEOLOGY AND MINING CONDITIONS.

The Geology of the property and the surrounding district has been fully covered by the Canada Geological Survey and the Department of Mines Ottawa and are reproduced at the left of the Sketch View of this Report. The MINING CONDITIONS are ideal for a low cost of production. Modern facilities such as Post Office, Telegraph, telephone, bank and stores are provided by the nearest towns and railway stations.

PROPOSED PLAN OF OPERATION.

The STANDARD MINING AND MILLING CO. LTD. after a careful study of all the available information were able to plan a definite program of development taking advantage of every physical features of the property and its relation to the nature of the deposit as a fertilizer instead of going after the pure Gypsum which would not only be more costly but restricted in tonnage available. The adopted plan allows for a run of Mine product with a very simple plan of extraction and preparation. The Gypsum deposits will be excavated by the Open quarry method by power Shovels then by trucks which will truck the broken down rock to the convenient gently sloping bench shown on the Sketch view. This gypsum rock will be allowed to dry in piles, then put through the Grinding mill where it will be reduced to a commercial product. From the Grinding mill a conveyor belt will convey the Gypsum Product to the loading bins which are located over the rail-way track where cars can be loaded by gravity with a minimum of handling. The SKETCH view of the Company proposed plan of operation is naturally subject to changes and is offered more as a suggestion to show the possibilities of this property and should not be taken as a final plan.

Respectfully submitted by

R. A. Brooke
 227 Vancouver Bldg.
 Vancouver B.C.

Made from Aerial photographs, plans and Government Reports.

CANADA DEPARTMENT OF MINES'S REPORT
— OTTAWA 1930 —
SPATSUM GYPSUM DEPOSITS.

Two exposures of gypsum-bearing rock occur on the hills forming the west bank of the Thompson River, immediately opposite Spatsum, a station on the main line of the Canadian Pacific railway, 183 miles northeast of Vancouver. The Canadian National Railway main line from Kamloops to Vancouver runs along the west bank of the Thompson river at the base of the hill in which the deposits occur. The property extends from the N.E. 1/4 Sec. 25, T. 18, Range 25, to S. 1/4 of the S.E. 1/4 of the Sec. 36, T. 18, Range 25, and fractions of the S. 1/4 of the S.W. 1/4 sec 31, T. 18, Range 24, and of the S. 1/4 of the S.W. 1/4 sec 30, T. 18, Range 24, totalling in all 450 acres. The property has a frontage on the river of about 3,300 feet.

The deposits are located about 600 feet above the level of the river, which has an elevation here of about 750 feet above sea-level. Two outcrops are plainly seen 2,000 feet apart. These occur on prominent bluffs, with a wide, shallow gully between them. The ground rises abruptly from the water's edge for about 200 feet vertical, and then continues in a 30-degree slope to the foot of the outcrop, which rises very steeply at a slope of about 50 degrees or more. The whole mass is badly disintegrated and highly altered. Plate XVII B shows a view of the more southerly outcrop.

The rocks of the district are mostly argillaceous schists, greywackes, hydro-mica schists, and some limestones.

The appearance of these two outcrops is very remarkable. Practically no vegetation or trees of any sort appear over the whole surface of the outcrops, which stand out prominently as large, white masses against the brownish green colour of the hills around. The material is mostly a dull white or grey, badly stained in places with iron oxides to a rusty yellow colour.

The larger and more southerly outcrop has a vertical height of about 300 feet, and a length along the strike of the beds of about 200 feet. Near the base of this exposure, and about its centre, a prospect tunnel has been driven into the hill for a distance of 25 to 30 feet, and from the end of this tunnel a winze has been sunk to a depth of 30 feet. The surface material consists of a badly disintegrated mass of mica schists, limestones, and shales, with frequent nodular lumps of white gypsum of varying size. After passing through this altered material, which has been lightly cemented, the tunnel cuts through a band of very pure, massive white gypsum, which on analysis gave the following results:—

Insoluble	0.04 per cent.
CaO	32.70 "
SO ₃	46.72 "
H ₂ O	20.60 "
	100.06 per cent.


This band, however, was only 5 feet wide, with a very light grey or white, highly altered limestone for the hanging wall and the rest of the length of the tunnel. This latter material showed on analysis a small amount of gypsum mixed with it. The winze is also wholly in this altered limestone. The band of pure gypsum has a strike about north 25 degrees east and a dip to the northwest of about 40 degrees.

The tunnel is the only place where this band is to be seen, as no stripping has been done on the surface to enable one to determine whether it has any great extent. Nothing in the way of prospecting has been carried on between the two outcrops, so that no definite statement can be made as to whether they belong to the same deposit or not; systematic development work and stripping will alone determine this. Before any estimate as to the value of the property can be given, the depth to which the gypsum extends will have to be determined as well as whether any other bands of pure material exist farther up the hillside. This latter is quite probable, and a series of trenches might reveal the presence of several more of these bands of workable material.

The property was first staked about the year 1896 by a prospector named Munro, who did a small amount of development work, but allowed the lease to lapse. It was then taken up about 1906 by Messrs. Sinclair and Spencer, who staked four mineral claims called the Mart, Flora, Mary and Belle, and these cover both outcrops. The claims were surveyed in 1907.

The situation of the property for opening up as a mine is ideal. A tunnel would open up whatever gypsum is present, and an aerial cableway would convey the material to the main line of the Canadian National railway, along the base of hill. No work has been done on these deposits in recent years so that its commercial value yet remains to be proven.

Plates 48 and 49, Publication 49716.
 The Gypsum Industry of Canada
 by L. Heber Cole, 1930.

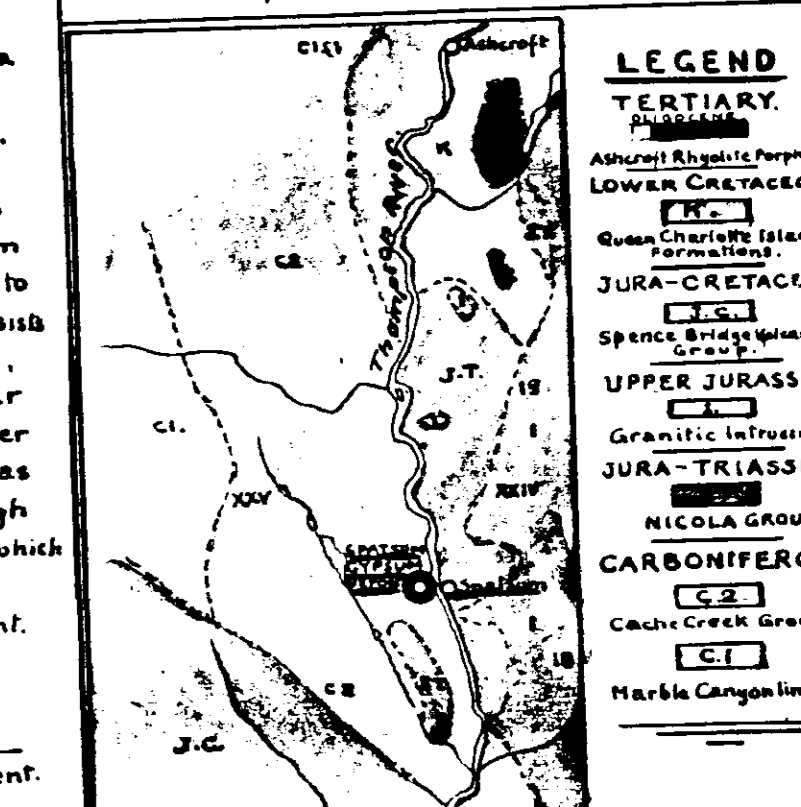

— GENERAL GEOLOGY. —

The Spatsum Gypsum deposits occur in the Cache Creek Formation, the oldest and most important economically formation of the district.
 Reference: G.M. Dawson - Kamloops sheet, 1894
 C.W. Orgdale - Sum. Report 1912, and Pre. Paper 46-2 by S. Duffell and K.C. McTaggart.

**BRITISH COLUMBIA
PROSPECTORS ASSISTANCE PROGRAM
PROSPECTING REPORT FORM (continued)**

B. TECHNICAL REPORT

- * One technical report to be completed for each project area
- * Refer to Program Requirements/Regulations, section 15, 16 and 17
- * If work was performed on claims a copy of the applicable assessment report may be submitted in lieu of the supporting data (see section 16) required with this TECHNICAL REPORT

Name DAVID JAVORSKY Reference Number 96/97 P-15

LOCATION/COMMODITIES

Project Area (as listed in Part A.) FERRY CREEK Minfile No. if applicable _____
Location of Project Area NTS 104 T-7W Lat 58° 18' N Long 128° 50' W
Description of Location and Access Helicopter From Deeselake to
Tennigan River Area, up Ferry Creek.

Main Commodities Searched For Gold

Known Mineral Occurrences in Project Area lots of Massive Sulfide, Jade
lots of placer Gold. No Gold values in the massive sulfides
that I sampled

WORK PERFORMED

1. Conventional Prospecting (area) Ferry Creek Claims
2. Geological Mapping (hectares/scale) _____
3. Geochemical (type and no. of samples) Sampling
4. Geophysical (type and line km) _____
5. Physical Work (type and amount) _____
6. Drilling (no. holes, size, depth in m, total m) _____
7. Other (specify) _____

SIGNIFICANT RESULTS (if any) see Report.

Commodities _____ Claim Name _____

Location (show on map) Lat _____ Long _____ Elevation _____

Best assay/sample type _____

Description of mineralization, host rocks, anomalies

Three zones of mineralization (Area of Placer Gold - unknown)
② Rocks containing Jade - Serpentine ③: flows of Massive Sulfide

Supporting data must be submitted with this TECHNICAL REPORT.

Ferry Creek Project.

1996 saw the release of the Regional Geochem Survey for the Cry Lake Map Sheet.

Dollie and I spent July 11th to July 18, 1996 camped on Ferry Creek taking samples of massive sulfide on the Ferry claims and along the bed of Ferry Creek.

The low precious metal value was disappointing. The claims were allowed to lapse without filing assessment work.

Probably the most disappointing thing was the weather. After a week of cold drizzling, rain and fog we were read to leave the Tournigan River area for good. This summer was terrible, and I've seen it so nice in the past.

The following two pages of gold assays each of heavily iron sulfide samples shows that we failed to get even close to the source of the 1978 Dupont gold anomaly, concentrated stream sediment sample.

The water was high in the creek prohibiting good stream sediment sampling.



Chemex Labs Ltd.

Analytical Chemists * Geochemists * Registered Assayers

212 Brooksbank Ave., North Vancouver
British Columbia, Canada V7J 2C1
PHONE: 604-984-0221 FAX: 604-984-0218

Page Number : 1
Total Pages : 2
Certificate Date: 24-SEP-96
Invoice No. : 19632767
P.O. Number :
Account : MML

Project :
Comments: CC: DAVID JAVORSKI ✓

CERTIFICATE OF ANALYSIS A9632767

SAMPLE	PREP CODE	Au g/t FA+AA										
R471	205 226	2.52										
R472	205 226	0.005										
R473	205 226	0.105										
R474	205 226	0.015										
R475	205 226	0.005										
R1722	205 226	0.050										
R1723	205 226	0.770										
T401	205 226	< 0.005										
T402	205 226	0.075										
T403	205 226	0.030										
T404	205 226	< 0.005										
T405	205 226	0.175										
T406	205 226	0.025										
T407	205 226	< 0.005										
T408	205 226	0.015										
T409	205 226	0.045										
T410	205 226	0.020										
T411	205 226	< 0.005										
T412	205 226	0.010										
T413	205 226	0.180										
T414	205 226	0.050										
T415	205 226	< 0.005										
T416	205 226	< 0.005										
T501	205 226	< 0.005										
T502	205 226	< 0.005										
T503	205 226	< 0.005										
T1101	205 226	< 0.005										
T1102	205 226	0.050										
T1103	205 226	0.015										
T1104	205 226	0.075										
T1105	205 226	0.215										
T1106	205 226	0.065										
T1107	205 226	0.090										
T1108	205 226	0.115										
T1109	205 226	< 0.005										
T1501	205 226	0.350										
T1502	205 226	0.460										
T1503	205 226	0.110										
T1504	205 226	< 0.005										
T1505	205 226	0.030										

CERTIFICATION: *David Javorski*



Chemex Labs Ltd.

Analytical Chemists * Geochemists * Registered Assayers
212 Brooksbank Ave., North Vancouver
British Columbia, Canada V7J 2C1
PHONE: 604-984-0221 FAX: 604-984-0218

Page Number :2
Total Pages :2
Certificate Date: 24-SEP-96
Invoice No. :19632767
P.O. Number :
Account :MML

Project :
Comments: CC: DAVID JAVORSKI

CERTIFICATE OF ANALYSIS A9632767

SAMPLE	PREP CODE		Au g/t FA+AA									
T1506	205	226	0.225									
T1507	205	226	0.065									
T1508	205	226	0.035									
T1509	205	226	0.045									
T1510	205	226	0.550									
T1511	205	226	< 0.005									
T1512	205	226	0.370									
T1513	205	226	1.090									
T1601	205	226	0.745									
T1602	205	226	0.190									

CERTIFICATION: *David Javorski*

**BRITISH COLUMBIA
PROSPECTORS ASSISTANCE PROGRAM
PROSPECTING REPORT FORM (continued)**

B. TECHNICAL REPORT

- One technical report to be completed for each project area
- Refer to Program Requirements/Regulations, section 15, 16 and 17
- If work was performed on claims a copy of the applicable assessment report may be submitted in lieu of the supporting data (see section 16) required with this TECHNICAL REPORT

Name Dave Javorosky Reference Number 96/7 - P15

LOCATION/COMMODITIES

Project Area (as listed in Part A.) Thumper Harris Creek Minfile No. if applicable _____

Location of Project Area NTS 824-2W Lat 50° 8.5' N Long 118° 50' W

Description of Location and Access up Harris Creek logging Road East of Lumby B.C.

Main Commodities Searched For Gold

Known Mineral Occurrences in Project Area Many Epithermal Alteration Zones
High Stream sediment Samples

WORK PERFORMED

1. Conventional Prospecting (area) Sampling - Stream Sampling
2. Geological Mapping (hectares/scale) _____
3. Geochemical (type and no. of samples) _____
4. Geophysical (type and line km) _____
5. Physical Work (type and amount) _____
6. Drilling (no. holes, size, depth in m, total m) _____
7. Other (specify) _____

SIGNIFICANT RESULTS (if any) see Report

Commodities _____ Claim Name Thumper

Location (show on map) Lat _____ Long _____ Elevation _____

Best assay/sample type _____

Description of mineralization, host rocks, anomalies

Host Rock is Very Altered to clay in area of Fault Controlled Fractures that provided plumbing to ancient Hydrothermal system.
The alteration zones are silica flooded producing banded quartz veins.

Supporting data must be submitted with this TECHNICAL REPORT.

Thumper Project 1996

The Thumper Exploration program presented more questions than it answered.

Concentrated panned samples from the tributary of Harris Creek below the showing of epithermal altered and banded quartz returned low values. See sample sheet.

While 240 ppb gold is significant, in a panned concentrate below a gold showing it should have been 24,000 ppb to justify the following up program.

When trying to concentrate a sample as much as possible by panning, one never knows if perhaps they have messed with it too much and float the fine gold over the edge of the pan. The gold in most epithermal deposits is very fine.

July 19th was spent taking pan samples and prospecting.


July 20th was spent prospecting and sampling.

July 21st was spent prospecting, sampling and trying to figure out the geometry of the quartz veins.

The VOS samples all show well banded epithermal style quartz veins in alteration zones, however all are low in gold value.

CONCLUSION There are various epithermal alteration zones on the Thumper Claims and in this tributary basin of Harris Creek. Exploration so far has found numerous epithermal style banded quartz veins in these alteration zones. So far I have not sampled the right one that is contributing the gold into Harris Creek.

From all of the signs this is a good place to do prospecting during hunting season. Deer were on the road, walking through camp, and looked very healthy. Maybe there's more to this prospecting than just finding gold.

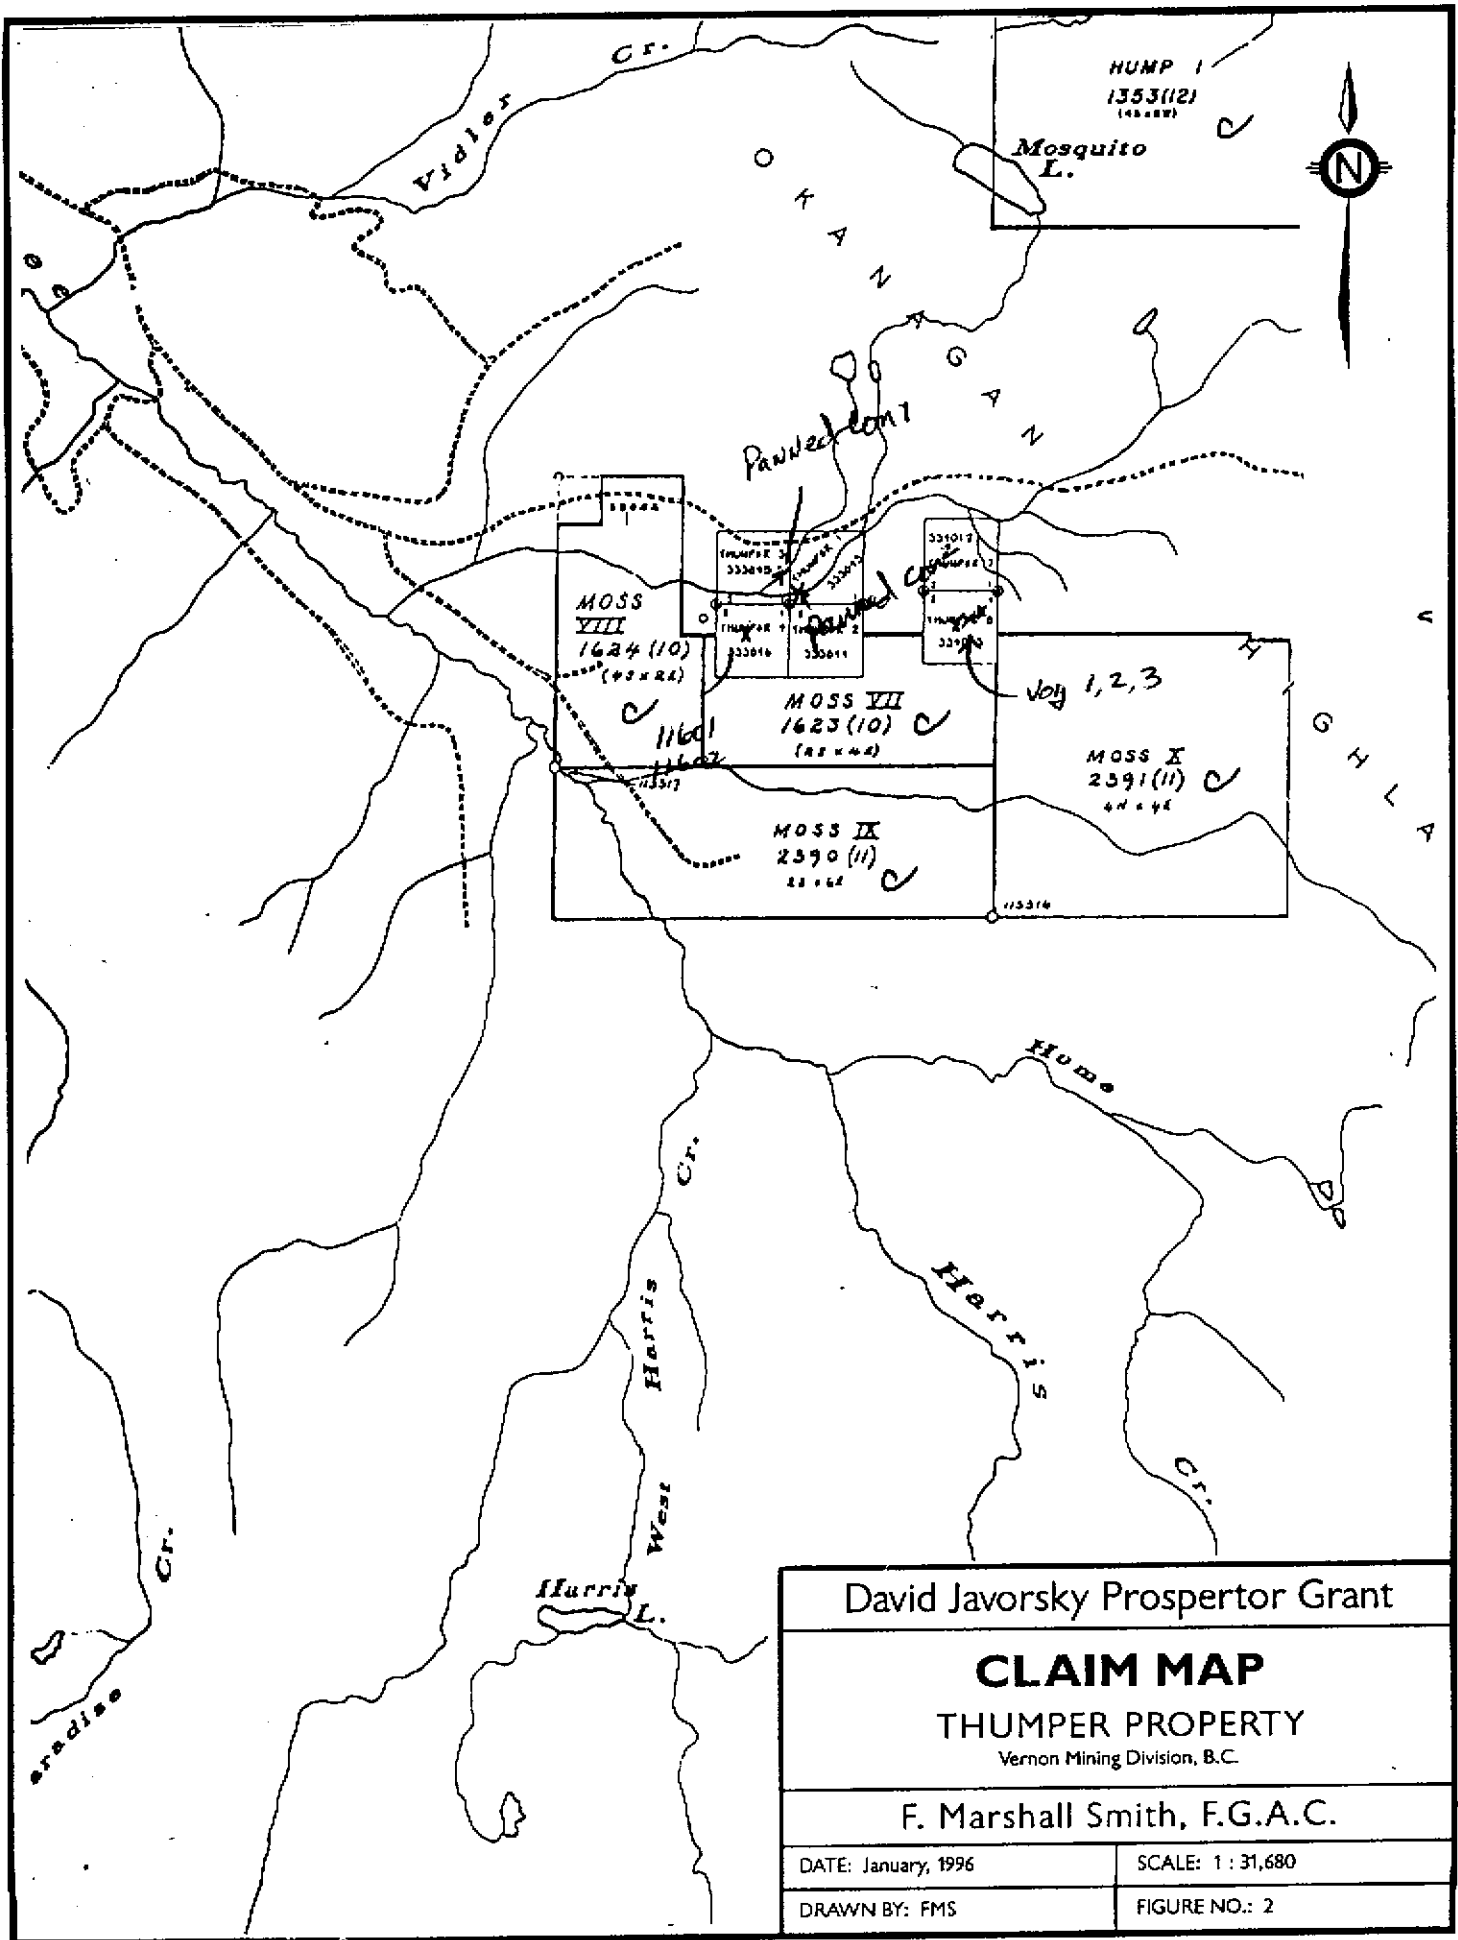

David Javorsky Prospector Grant

CLAIM MAP
THUMPER PROPERTY
 Vernon Mining Division, B.C.

F. Marshall Smith, F.G.A.C.

DATE: January, 1996

SCALE: 1:31,680

DRAWN BY: FMS

FIGURE NO.: 2

ROSSBACHER LABORATORY LTD.

CERTIFICATE OF ANALYSIS

2225 Springer Ave., Burnaby,
British Columbia, Can. V5B 3N1
Ph:(604)299-6910 Fax:299-6252

To : Dave Javorski
PO Box 608
Stewart, B.C.
Project: Royal Mint
Type of Analysis: ICP

Certificate: 96099
Invoice: 50641
Date Entered: 96-08-07
File Name: DJ96099.1
Page No.: 1

PRE FIX	SAMPLE NAME	PPB Au AA	PPM Ag	% Al	PPM As	PPM B	PPM Ba	PPM Be	PPM Bi	% Ca	PPM Cd	PPM Co	PPM Cr	PPM Cu	% Fe	PPM Hg	% K	PPM La	% Mg	PPM Mn	PPM Mo	% Na	PPM Ni	PPM P	PPM Pb	PPM Sb	% Si	PPM Sr	% Ti	PPM V	PPM W	PPM Zn
A1	ROYALMINT1	90	2.7	0.56	53	204	121	1	1	0.53	1	10	45	15	3.41	ND	0.33	7	0.18	397	2	0.01	6	1631	32	1	0.04	14	0.01	17	1	41
A1	ROYALMINT2	10	0.9	0.60	25	11	89	1	1	0.05	1	2	199	44	2.85	ND	0.08	8	0.27	421	2	0.01	11	405	11	2	0.03	5	0.01	24	1	59
A1	ROYALMINT3	5	0.3	1.19	8	7	126	1	1	0.57	1	15	111	139	3.59	ND	0.23	9	0.33	474	1	0.03	13	1720	10	4	0.03	31	0.01	41	1	58
A1	ROYALMINT4	10	0.8	0.80	16	107	127	1	1	0.04	1	8	95	39	2.18	ND	0.19	10	0.37	289	1	0.03	16	362	10	4	0.03	5	0.01	19	1	78
A1	ROYALMINT5	30	1.4	0.74	139	525	60	1	1	0.32	2	12	71	26	4.65	ND	0.28	17	0.24	50	1	0.01	4	1947	26	12	0.05	13	0.01	11	1	157
A1	ROYALMINT6	5	0.2	0.90	17	21	128	1	1	2.61	1	9	48	9	4.44	ND	0.24	11	0.73	2602	1	0.05	1	1994	12	5	0.04	152	0.01	7	1	64
A1	ROYALMINT7	5	1.1	1.08	21	133	144	1	1	0.01	1	11	38	42	3.09	ND	0.20	12	0.52	376	3	0.03	17	259	14	6	0.04	2	0.01	17	1	63
A1	11601	10	0.4	0.36	10	14	732	1	4	0.05	1	1	65	5	0.71	ND	0.33	46	0.02	109	2	0.03	1	136	22	1	0.04	45	0.01	1	1	36
A1	11602	5	0.2	0.39	4	70	474	1	1	0.02	1	1	118	5	1.48	ND	0.35	24	0.05	36	5	0.03	1	364	45	1	0.04	49	0.01	2	1	24
A1	VOY-1	10	2.1	0.46	2	7	92	1	7	0.08	1	1	102	8	1.09	ND	0.43	43	0.04	93	3	0.04	1	468	206	1	0.04	46	0.01	3	1	222
A1	VOL-2	5	0.2	0.86	7	18	166	2	1	5.01	1	4	109	74	3.79	ND	0.02	10	0.08	2216	38	0.03	19	1060	9	1	0.21	44	0.08	136	308	36

PRE FIX	SAMPLE NAME	PPB Au AA	% Zn	Assay Ag Q/T	PPM Ag	% Al	PPM As	PPM Ba	PPM Be	PPM Bi	% Ca	PPM Cd	PPM Co	PPM Cr	PPM Cu	% Fe	PPM Hg	PPM La	% Mg	PPM Mn	PPM Mo	% Na	PPM Ni	PPM P	PPM Pb	PPM Sb	% Si	PPM Sr	% Ti	PPM V	PPM W	PPM Zn
P	18001	20			0.8	0.36	40	16	1	1	1.37	1	3	121	18	0.92	ND	3	0.27	286	4	0.01	10	343	30	8	0.01	43	0.01	29	5	38
P	18002	80			1.0	0.70	100	24	1	1	0.18	1	6	52	36	2.52	ND	6	0.41	489	3	0.02	4	463	68	4	0.01	17	0.01	92	1	143
P	18003	7000			18.6	0.48	40	34	1	1	0.32	4	5	111	43	1.46	ND	4	0.31	574	6	0.02	7	348	127	3	0.01	27	0.01	54	2	365
P	18004	40			1.2	0.87	195	39	1	5	0.22	3	5	43	58	3.59	ND	8	0.49	537	5	0.03	6	642	125	8	0.01	25	0.01	118	7	265
P	18005	3000			2.8	0.48	26	34	1	4	0.26	1	4	129	65	1.31	ND	1	0.33	288	2	0.03	8	240	16	2	0.01	17	0.03	49	6	49
P	18006	60			30.7	1.57	165	100	1	1	5.34	221	10	70	89	3.61	ND	1	1.32	2029	5	0.05	24	1263	9308	86	0.01	356	0.08	55	8	26095
P	18007	10			0.3	0.47	13	17	1	1	8.63	1	2	54	25	1.07	ND	5	0.36	2221	2	0.01	6	354	9	1	0.01	229	0.01	42	1	58
P	18008	10			0.2	0.50	34	17	1	2	1.58	1	3	90	25	1.14	ND	3	0.39	536	1	0.01	9	382	16	8	0.01	54	0.01	50	8	26
P	18009	5			0.9	0.35	35	19	1	1	1.89	1	3	143	14	0.98	ND	3	0.20	418	1	0.02	4	248	21	6	0.01	65	0.01	42	8	39
P	18010	5			0.8	0.65	38	50	1	1	0.75	2	7	38	98	1.89	ND	7	0.39	496	1	0.02	4	431	171	8	0.01	38	0.12	82	8	181
P	18011	5			0.3	1.49	22	82	1	1	3.22	1	18	26	158	4.03	ND	9	1.10	1137	2	0.04	12	1676	7	1	0.02	141	0.18	191	1	99
P	18012	2600	5.10	336.5	283.4	1.13	8065	69	1	1	1.39	600	30	64	826	4.20	ND	1	0.63	876	5	0.06	17	1261	24274	1094	0.01	197	0.04	37	1	>5%
P	18013	10			0.6	0.67	32	32	1	5	0.73	2	5	92	32	2.03	ND	5	0.45	570	1	0.02	6	494	129	2	0.01	16	0.01	76	9	127
P	18014	5			1.0	0.61	23	48	1	2	0.91	1	7	25	478	1.10	ND	2	0.22	142	1	0.02	5	2177	20	12	0.02	37	0.16	30	5	18
P	pan con. 1	5			8.6	1.92	145	189	1	5	1.21	3	14	117	170	3.97	ND	7	1.07	1173	5	0.12	14	1770	342	13	0.01	109	0.20	118	11	326
P	pan con. 2	240			0.8	2.16	102	293	1	3	1.34	1	11	116	111	3.54	ND	9	0.97	819	2	0.28	16	1557	51	10	0.01	160	0.22	120	7	128
P	4013-1	230	487.4		307.0	0.80	130	362	1	1	0.28	69	7	22	261	3.69	ND	10	0.30	9671	2	0.03	1	858	10755	108	0.01	37	0.01	12	23	7366
P	4013-2	70	315.6		248.6	0.93	85	184	1	1	0.38	49	11	29	150	3.75	ND	10	0.40	9112	4	0.03	1	793	6758	95	0.01	32	0.01	15	22	6203
P	4013-3	70	274.6		229.1	0.93	83	152	1	1	0.32	51	9	24	171	3.49	ND	12	0.41	9038	2	0.03	2	898	5465	95	0.01	28	0.01	15	22	6327
P	4013-4	60	211.6		175.6	0.86	81	170	1	1	0.74	44	9	24	129	2.96	ND	9	0.42	7307	2	0.03	2	833	4111	74	0.01	47	0.01	14	19	4699
P	4013-5	80	162.6		147.7	0.44	52	143	1	1	0.47	65	4	34	60	2.23	ND	11	0.19	7630	3	0.02	1	692	3099	48	0.01	21	0.01	4	17	4998
P	4013-6	140	490.5		244.5	0.86	86	161	1	1	0.20	69	8	28	255	3.83	ND	11	0.32	9958	3	0.03	1	918	11857	148	0.01	20	0.01	13	23	6952
P	4013-7	70	312.0		229.8	0.75	32	211	1	1	0.19	57	8	30	118	3.32	ND	10	0.31	10296	2	0.03	1	839	6193	58	0.01	23	0.01	11	21	6466

ROSSBACHER LABORATORY LTD.

CERTIFICATE OF ANALYSIS


2225 Springer Ave., Burnaby,
British Columbia, Can. V5B 3N1
Ph:(604)299-6910 Fax:299-6252

To : Dave Javorski
PO Box 608
Stewart, B.C.

Certificate: 96099 A
Invoice: 50646
Date Entered: 96-08-09
File Name: DJ96099.A
Page No.: 1

Project:
Type of Analysis: Assay

PRE FIX	SAMPLE NAME	oz/t Au
A1	VOY 3 +28	0.001
A1	VOY 3 -28 + 40	0.002
A1	VOY 3 -40 + 100	0.001
A1	VOY 3 -100 + 140	0.001
A1	VOY 3 -140	0.002

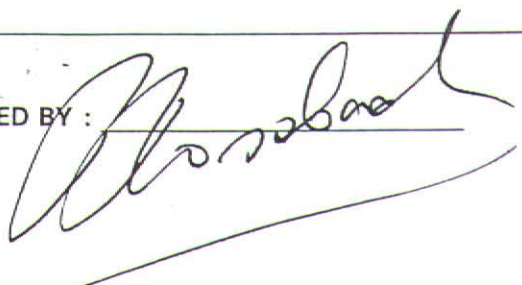CERTIFIED BY : 

BRITISH COLUMBIA
PROSPECTORS ASSISTANCE PROGRAM
PROSPECTING REPORT FORM (continued)

B. TECHNICAL REPORT

- One technical report to be completed for each project area.
- Refer to Program Requirements/Regulations, section 15, 16 and 17.
- If work was performed on claims a copy of the applicable assessment report may be submitted in lieu of the supporting data (see section 16) required with this TECHNICAL REPORT.

Name Dave Javorsky Reference Number 96-97 P-15

LOCATION/COMMODITIES Blue chip
Project Area (as listed in Part A) Laidlaw MINFILE No. if applicable 92H SW 017

Location of Project Area NTS 92H-5E Lat 49° 18' Long 121° 36'

Description of Location and Access Accessible by old mine road.

Main Commodities Searched For Gold

Known Mineral Occurrences in Project Area Blue chip 4 Adits
Also know as Diawe

WORK PERFORMED

1. Conventional Prospecting (area) Near Adits.
2. Geological Mapping (hectares/scale) _____
3. Geochemical (type and no. of samples) _____
4. Geophysical (type and line km) Beep mat IV survey
5. Physical Work (type and amount) _____
6. Drilling (no., holes, size, depth in m, total m) _____
7. Other (specify) _____

SIGNIFICANT RESULTS see Report
Commodities _____ Claim Name _____

Location (show on map) Lat _____ Long _____ Elevation _____

Best assay/sample type _____

Description of mineralization, host rocks, anomalies _____

Supporting data must be submitted with this TECHNICAL REPORT
Information on this form is confidential for one year from the date of receipt subject to the provisions of the *Freedom of Information Act.*

The BLUE CHIP PROJECT 1996

Eight Man days were spent prospecting in the Laidlaw area 4 day by D. Javorisky and 4 days by J. P. Loiselle, who owns a BeepMat & Geophysical Exploration-Prospecting tool.

October 18, 1996. Travelling to Area, setting up camp. accessing property, Calibrating BeepMat instrument. Prospecting in creek. Mapping.

October 19, 1996. Running Beep Mat Survey. From access road to Blue Chip mine portals. Running back and forth above and below ~~add~~ adits. Mapping, and Prospecting.

October 20, 1996: using the Beep Mat as a prospecting tool around the showings and extending out into the surrounding hill side.

Summary The granit around the Quartz Veins show alteration and they are depleted in magnetite. They show up to the BeepMat as a mag low. (See map.)


The Fractures in the area are tight and pinch out quickly.

October 21, 1996: Went prospecting across creek with beep mat to a old showing of Anglo-Canadian Nickel which I had previously staked in 1972 and again in 1987. Here the Beep Mat worked excellently. The Beep Mat showed up mineralized float 30 meters from its source. The zone of massive Sulfide ^{SAMPLE} 8161-2 and -5 is 4 feet wide and the low grade zone extends up to 13 feet wide. With the Beep Mat we were able to obtain the highest grade of both conductor and magnetite. We were able to follow the zone under moss for 100 meters up hill. The Peridotite dike, Fracture filling, ?, Follows the contact for quite a ways northerly. See map and Assaysheets.


Summary Beep Mat worked good, outlined mineral zone, however surface values are sub marginal.

BLUE CHIP MINERAL CLAIM


TENDURE No. 342046

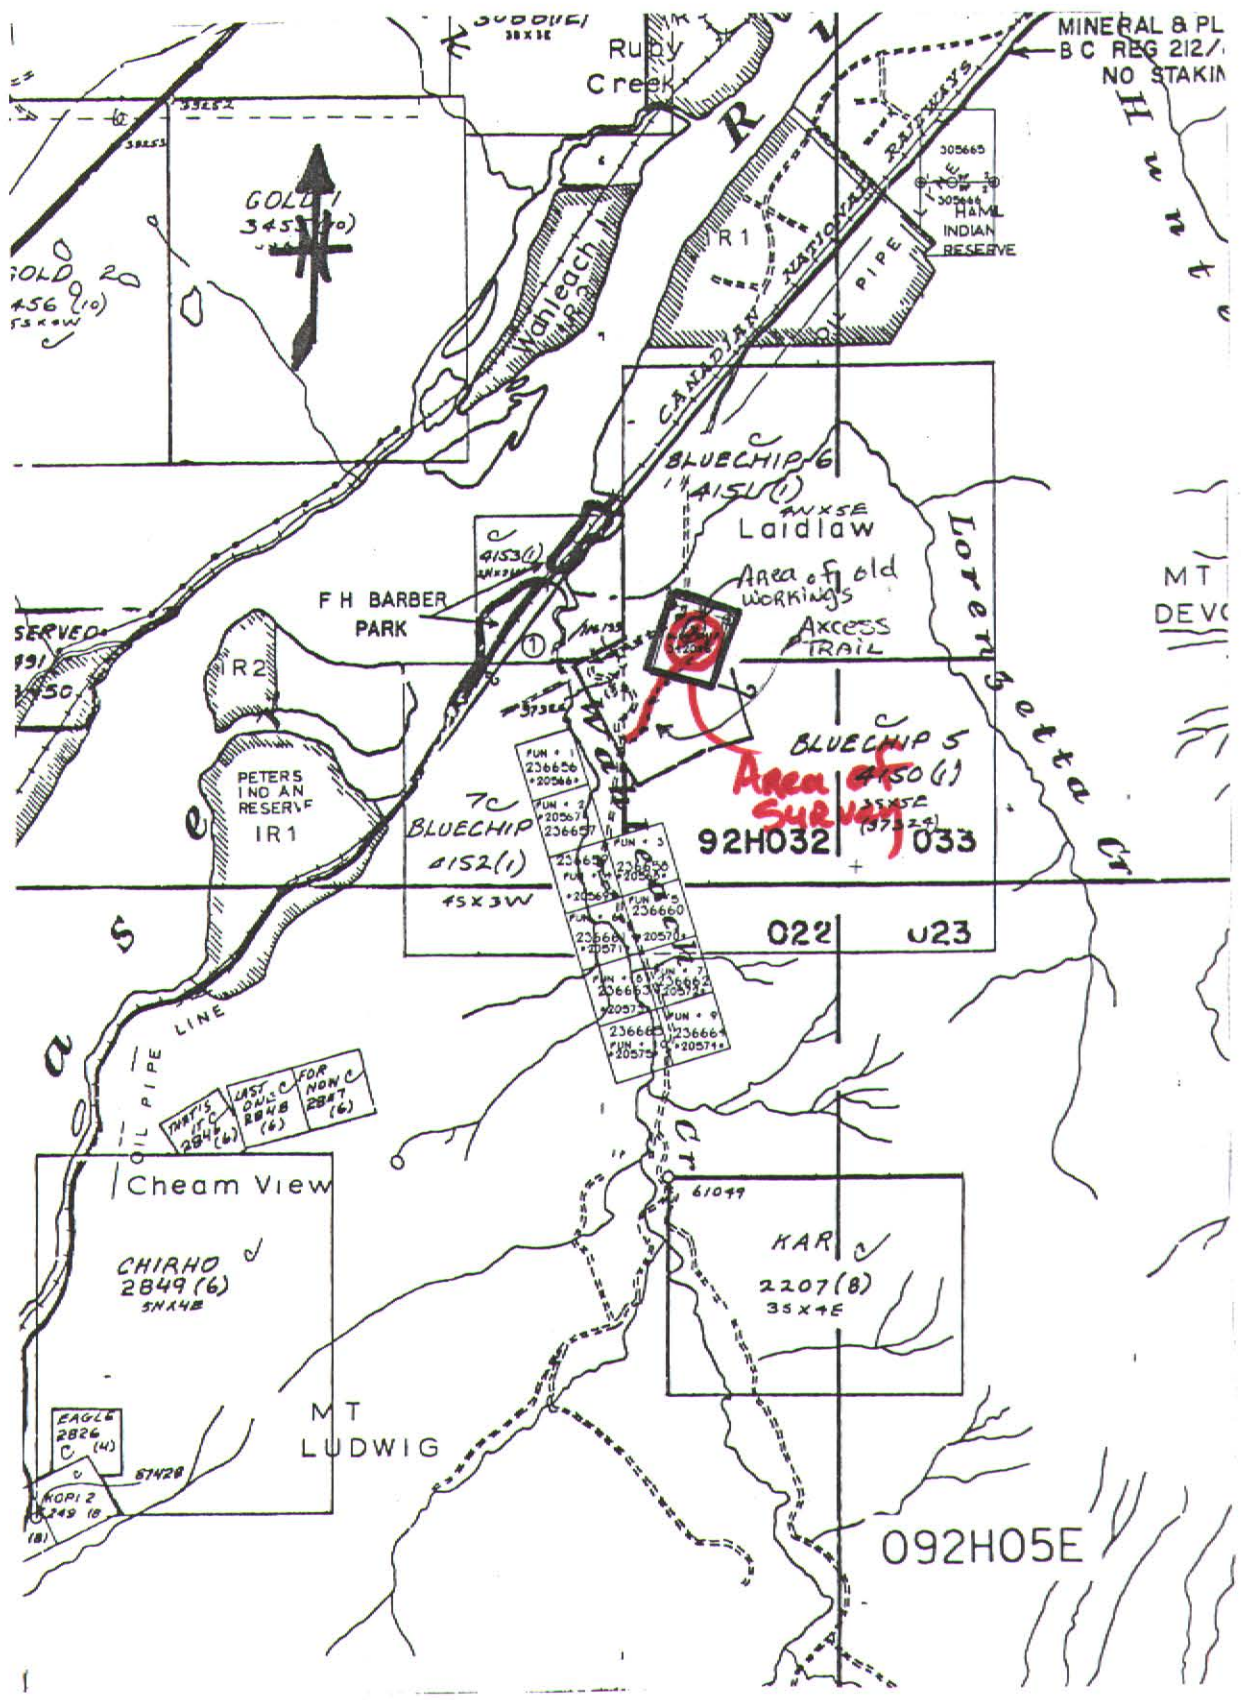

QUARTZITE SHALE

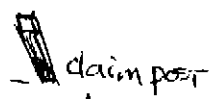

Claim line

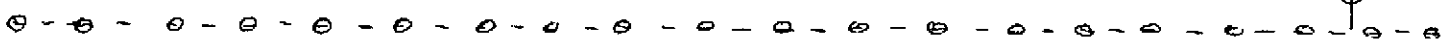

claim post

Blue Chip Mineral Claim

Dave Javorsky 1996

OVER GROWN ROAD

GRANIT

HORNBLEND PORPHYRY

GRANIT

sluff in creek adit

CREEK VEIN

Central and West Adit Caved at Portal

East Adit in good condition

METASEDIMENTARY

Blue Chip.

GRANIT PORPHYRY

faults
faults
faults

GRANIT VEIN 2


GARNET SHIST
Vein 3
10°

20°

GARNET SHIST


Dave Javarsky

Blue chip
Beep Mat.

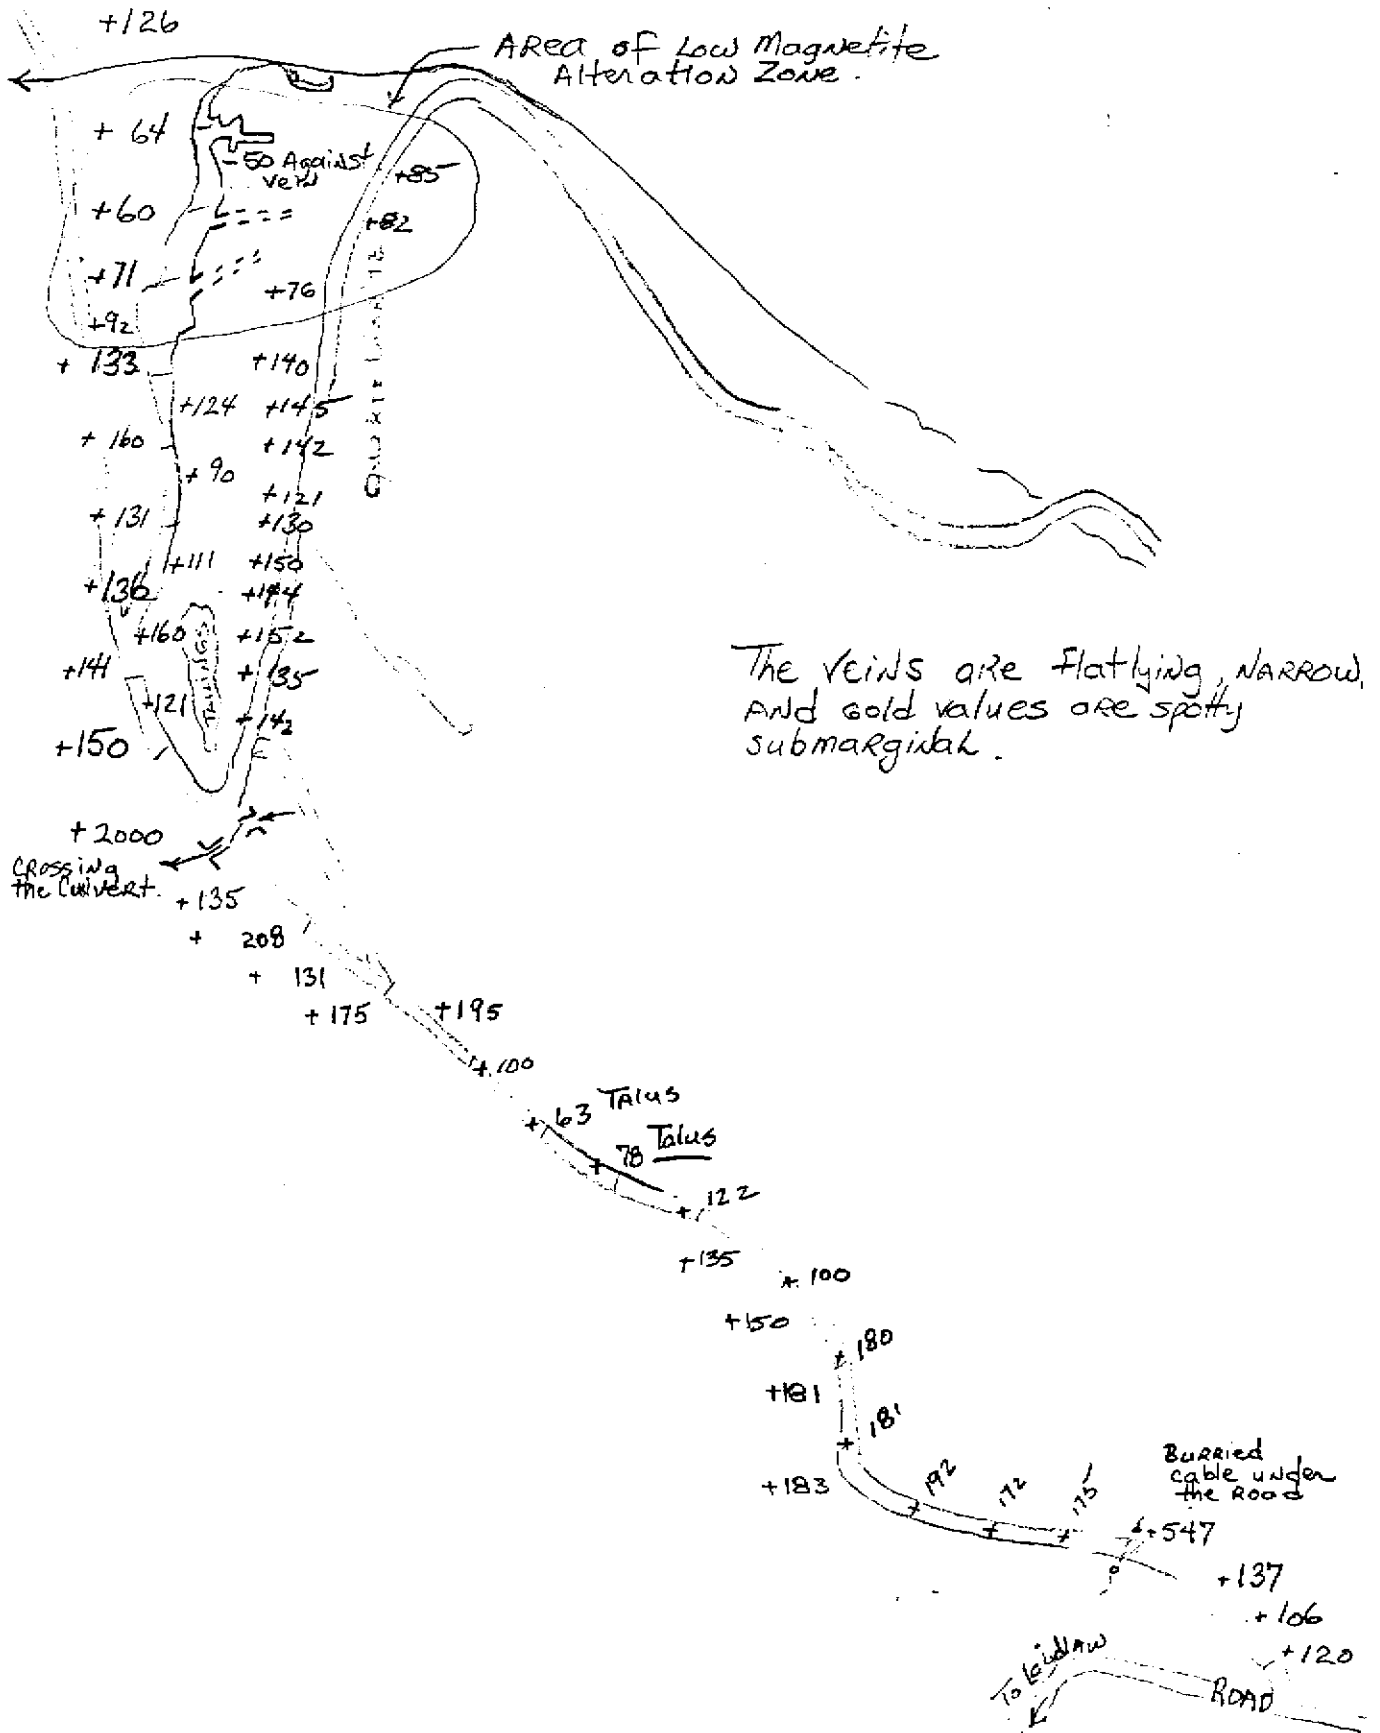

DAVID JAVORSKY 1996

Blue Chip - Laidlaw - "DAVIE"

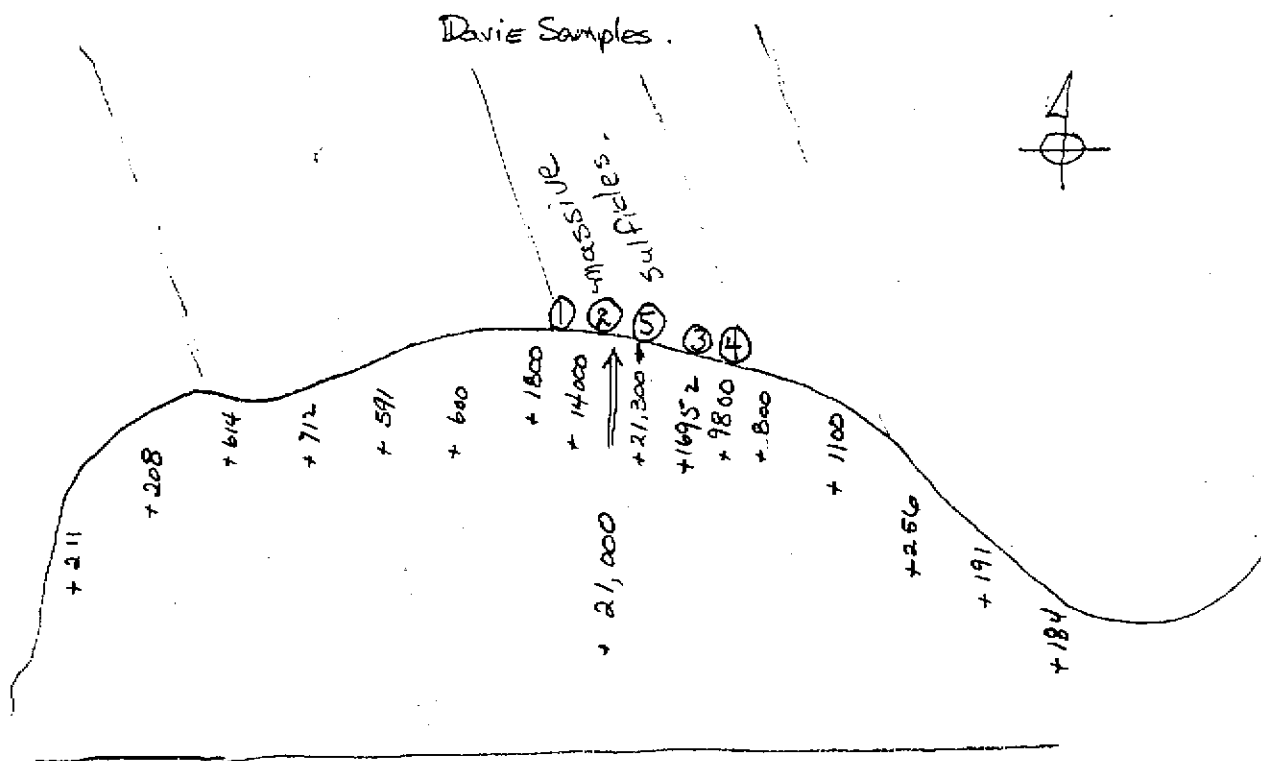

	Copper	Au ounces/ton
Sample Daviel 8161.001	0.3%	0.005
Daviel 8161.002	0.2%	0.001
Daviel 8161.003	0.1%	0.001
Daviel 8161.004	0.1%	0.001
Daviel 8161.005	0.3%	0.002

The rock was weathered, however the assays are submarginal.

quanta trace laboratories inc.

#401-3700 Gilmore Way, Burnaby, B.C., Canada V5G 4M1

Tel: (604) 438-5226

To: Mr. D. Javorsky

W/O: B161 Page 2

Anglo-Canadian Nickel - Davie M.C. Hope.

Sample type		Rock	Rock	Rock	Rock	Rock
Identification		Davie 1	Davie 2	Davie 3	Davie 4	Davie 5
Lab Reference #		B161-001	B161-002	B161-003	B161-004	B161-005
Analyzed by Plasma Emission Spectroscopy (ICAP)						
Method used		Total	Total	Total	Total	Total
Trace Elements						
Silver	Ag	1.4	2.0	1.6	1.4	1.5
Arsenic	As	< 30	< 30	< 30	< 30	< 30
Boron	B	< 1.	< 1.	< 1.	< 1.	< 1.
Beryllium	Be	0.2	0.1	0.1	0.1	0.1
Bismuth	Bi	< 20	< 20	< 20	< 20	< 20
Cadmium	Cd	< 0.3	< 0.3	< 0.3	< 0.3	< 0.3
Cobalt	Co	232	315	193	78	202
Chromium	Cr	50.	124.	192.	275.	134.
Copper	Cu	3310 .3%	2470 .2%	1560 .1%	1850 .1%	3370 .3%
Mercury	Hg	< 10	< 10	20	10	< 10
Molybdenum	Mo	< 3	< 3	< 3	< 3	< 3
Nickel	Ni	650	1080	570	202	790
Lead	Pb	< 5	< 5	< 5	< 5	< 5
Antimony	Sb	< 10	< 10	< 10	< 10	< 10
Selenium	Se	< 10	< 10	< 10	< 10	< 10
Thorium	Th	< 5	< 5	< 5	< 5	< 5
Uranium	U	< 30	< 30	< 30	< 30	< 30
Vanadium	V	617.	297.	272.	487.	242.
Zinc	Zn	6	20	32	56	44
Results in		ppm	ppm	ppm	ppm	ppm
Precious Metals by Fire Assay						
Gold	Au	0.005	0.001	0.001	0.001	0.002
Palladium	Pd	0.0020	0.0064	0.0020	0.0024	0.0030
Platinum	Pt	0.0010	0.0010	0.0008	0.001	0.0008
Rhodium	Rh	< 0.001	< 0.001	< 0.001	< 0.001	< 0.001
Results in		oz/T	oz/T	oz/T	oz/T	oz/T
Majors as Oxides						
Silicon	% SiO2	31.5	28.0	40.3	51.3	29.1
Aluminum	% Al2O3	7.63	3.60	6.67	8.53	2.33
Iron	% Fe2O3	34.4 %	44.8 %	30.6 %	19.2 %	42.7 %
Calcium	% CaO	12.7	8.66	4.21	3.34	4.18
Magnesium	% MgO	2.05	3.80	6.19	8.29	6.20
Sodium	% Na2O	0.54	0.69	1.35	1.70	0.31
Potassium	% K2O	0.58	0.10	0.22	0.66	0.26
Barium	% BaO	0.055	0.006	0.014	0.030	0.011
Manganese	% MnO	0.33	0.10	0.26	0.33	0.207
Phosphorus	% P2O5	1.21	2.37	0.77	0.26	2.33
Strontium	% SrO	0.089	0.020	0.030	0.036	0.010
Titanium	% TiO2	0.26	0.43	3.14	4.73	1.41
Zirconium	% ZrO2	0.029	0.005	0.005	0.005	0.008
Loss on Ignition		6.68	6.24	5.49	0.18	9.18
Total Oxides %		98.1	98.9	99.3	99.0	98.3

Assayer: *[Signature]*

1996 PROSPECTING ASSISTANT Exploration Services

J. P. Loiselle


J.P. Loiselle is a graduate of the B.C. M of E. M. & P. R. Advanced Prospecting School.



EXPERIENCE FIELD TECHNICIAN

ELECTROMAGNETIC PROSPECTION

Response observed by a Beep Mat survey

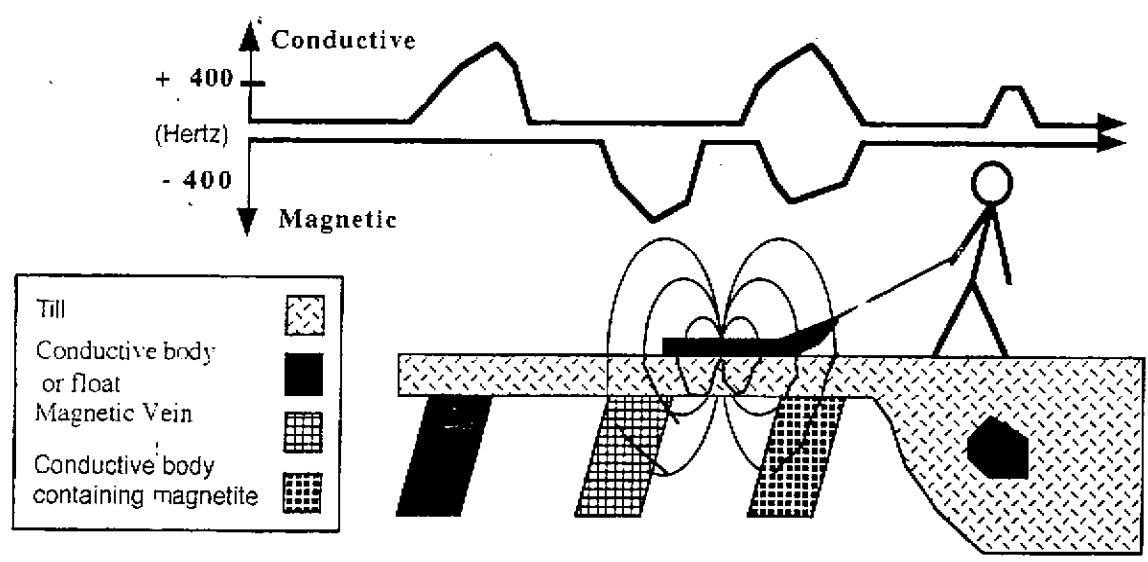

The BEEP MAT BM IV, detects efficiently conductive and magnetic outcrops and boulders down to 1,5 m. of overburden.

Under the moss and in the overburden it is possible to map the scattering of a trail of floats or (and) boulders and find its source.

BEEP MAT, model BM-IV

It Now Detects Small Conductors in a Magnetic Environment

The BM-IV is a powerful miniaturized electromagnetic survey instrument that efficiently and inexpensively detects conductive and magnetic outcrops or boulders hidden down to 1.5 meters of overburden.


Due to its size, weight and shape, the Beep Mat can easily be pulled through the bush. When it beeps, you know that the conductor causing the anomaly is right under the Beep Mat.

You can then immediately trench and take a sample for assay to determine if it is a valuable showing or a barren sulfide/graphite conductor.



Features

- ⇒ Magnetite and conductive materials each have a different audio signal and their relative value is displayed to help pinpoint the high sulfide.
- ⇒ The sensor consists of a rugged waterproof unicoil inserted in a polyethylene shell.
- ⇒ A large, bright dot matrix LCD displays clear, readable, simultaneous measurements of the conductivity and susceptibility (magnetite content) of the underlying material.
- ⇒ It detects sulfide conductors such as: pyrite, pyrrhotine, pyrrhotite, chalcopyrite (Cu), graphite, pentlandite (Ni), galena (Pb), etc. and even silver (Ag), or gold (Au) nuggets and veinlets.

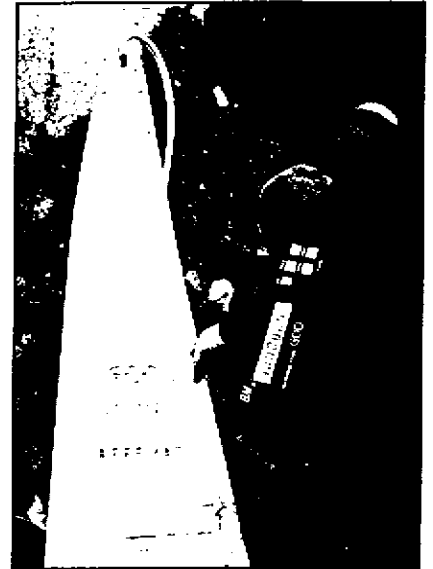

Compare the cost:

Beep Mat survey

Standard geophysical survey

Staking:	Only when a showing is found	All the time, at \$ 100 per claim
Line cutting:	None, only sampled sites with GPS	All the time, at \$ 200 per km
Readings:	Continuous: every 1/10 of a second	25-meter spacings
Plotting:	Only of the sites sampled	Yes, all the readings on maps
Interpretation:	Immediately in the bush	After interpreting in the office, a second trip is necessary for sampling
Stripping:	With a shovel	With a bulldozer, at \$ 100 per hour
Drilling:	Only the promising showings	All the barren conductors
Typical cost per conductor sampled and assayed:	\$ 500 to \$ 2,000	\$ 20,000 to \$ 50,000

By using BM-IV Beep Mats on your properties, you can:

- ⇒ Sample as many conductive outcrops and boulders in one summer as a mining company can drill in ten years of standard exploration.
- ⇒ With today's smaller budgets, localize, sample and assay 10 times as many conductors as you had in the past.
- ⇒ Discover, during your summer, several high-grade showings which will warrant drilling.
- ⇒ By a standard approach, less than 1% of all drilled geoscientific targets will warrant additional drilling. Sampling with Beep Mats saves the cost of hundreds of barren D.D.H. and upgrades the value of targets which are drilled.

**BRITISH COLUMBIA
PROSPECTORS ASSISTANCE PROGRAM
PROSPECTING REPORT FORM (continued)**

B. TECHNICAL REPORT

- * One technical report to be completed for each project area
- * Refer to Program Requirements/Regulations, section 15, 16 and 17
- * If work was performed on claims a copy of the applicable assessment report may be submitted in lieu of the supporting data (see section 16) required with this TECHNICAL REPORT

Name _____ Reference Number _____

LOCATION/COMMODITIES Wild Rose Claims
Project Area (as listed in Part A.) Toadoggonid AREA Minfile No. if applicable _____
Location of Project Area NTS 94 E 6 E Lat _____ Long _____
Description of Location and Access Toadoggonid River Area 3 kilometers East of the Baker mine site.

Main Commodities Searched For Gold

Known Mineral Occurrences in Project Area Wild Rose

WORK PERFORMED

1. Conventional Prospecting (area) Prospecting
2. Geological Mapping (hectares/scale) _____
3. Geochemical (type and no. of samples) _____
4. Geophysical (type and line km) Scintometer Survey For Potassium Alteration
5. Physical Work (type and amount) VLF R. Resistant Survey
6. Drilling (no. holes, size, depth in m, total m) _____
7. Other (specify) _____

SIGNIFICANT RESULTS (if any) see Report

Commodities _____ Claim Name _____

Location (show on map) Lat _____ Long _____ Elevation _____

Best assay/sample type _____

Description of mineralization, host rocks, anomalies
Epithermal Alteration has high gold in Quartz, Float Sample.

Supporting data must be submitted with this TECHNICAL REPORT.

Wild Rose Project 1996

Situated in the Toadoggond River mining camp, 2 kilometers east of the North East corner of the 'Baker Mine' surveyed mining lease, the Wild Rose claims are prime exploration targets.

The Wild Rose claims were staked on the morning of September 29th 1996 after a light snow fall the previous evening. Two weeks later when attempting to do further prospecting we were hampered by more snow.

The Toadoggond-Baker mine area is beautiful country in which to do geological prospecting. Above Timberline the formations show up spectacularly. The following two pictures taken during the staking, before the camera froze up, show the epithermal alteration zones and how well they stand out.

(Top) Looking from the post westerly across the valley to the area north of Elz Vein; a whitish-yellowish Kayalite clay zone stands out prominently. This zone is the cap of a old hot spring. The clay zone starts about 600 meters west of the post. Out of sight in the top picture is the brown outer perimeter to the Hot Springs alteration zone. Its rustiness is from remobilized iron away from the heat sources. This brown rusty zone is quite similar to the Rusty zone seen in the distance near the Baker B Vein.

Notice the unaltered volcanic rock at the claimpost cairn. In the second picture the brown perimeter gossan stands out, even with some snow on it. It is about 200 meters in front-left of where the picture was taken.

The surface expression of this alteration zone is quite similar to the Baker B Vein' situated 3 kms to the west. Currently mining activity is taking place at the Baker mine.

In 1982, geologist Larry Buchanan formed a model for the high acid-low pH-Epithermal-Bonanza zone type mineral deposit. While Buchanan's work was done in Arizona, USA and Mexico, it correlates well with the showings at the Baker mine.

On October 9th, 10th and 11th, accompanied by Dollie Jakobsky who is also a graduate of the British Columbia M. & E. M. & P. R. Advance Prospecting School, the Wild Rose claims were given a first Pass inspection. The ground was frozen and snow covered.

October 9, 1996; setting up camp, putting in Base lines over the north and south zones of alteration.

Using a URTEC MINI SCINT three lines were ran over the alteration zone. The effect was to measure the amount of potassium (K) alteration. The results indicate that over the cooked up alteration zone there is a depletion of potassium. The snow attenuated the signal quite a bit. 5-10 second readings were averaged at each station. See the following map: Wild Rose MiniScient Survey, Channel T-2.

October 10th and 11th, 1996. These two days were spent running a Ronka EM-16 R survey to outline the surface resistance over the alteration zones. It did not have enough power to obtain readings on the south alteration zone. The northern zone had the snow blown off of it. This type of a survey gives some indication of the amount of alteration in the Epithermal cooked up zone. See the following map. Wild Rose Surface Resistance Map.

INTENSE ALTERATION ZONE




Wild Rose Miner
CLAIMS 94E6E


Shows Alterations
Zones Along the
claim line
looking Westerty.

WESTERTY



Very Rusty
Pinnite
Alteration Zone

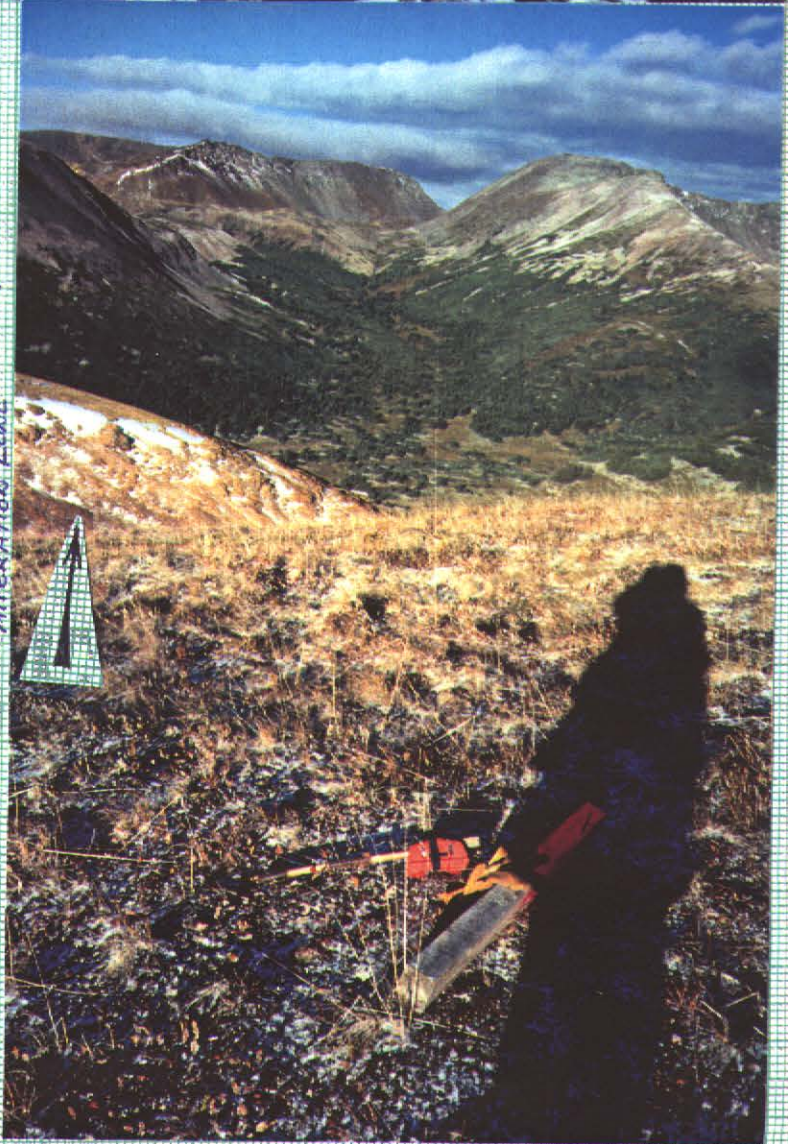

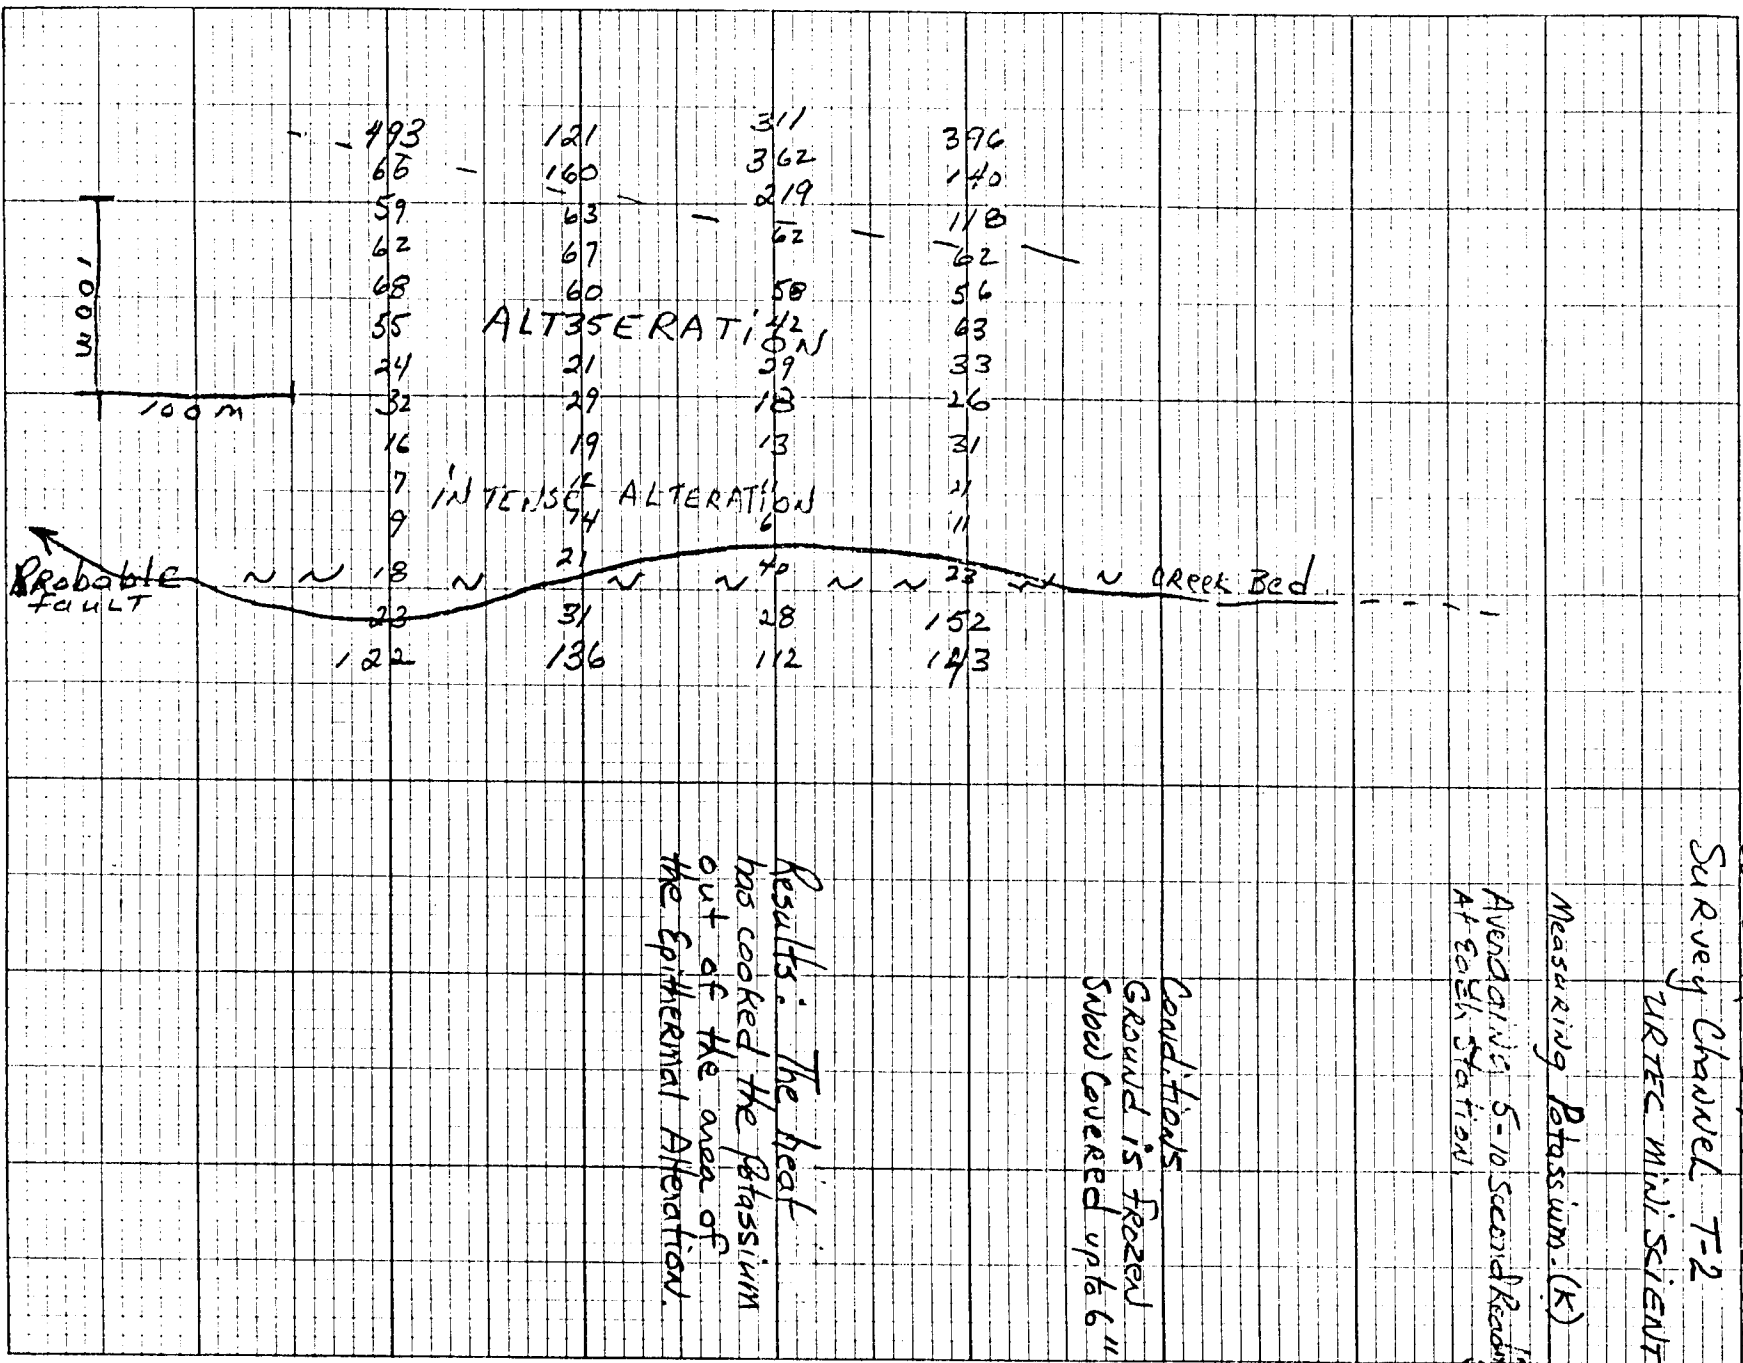

Wild Rose Mini-Sheet

Survey Channel T-2


URTEC MINI-SHEET

Measuring Potassium (K)

Average 5-10 Second Reading
At each Station

Conditions
Ground is frozen
Snow covered up to 6"

Results: The heat
has cooked the potassium
out of the area of
the Epithermal Alteration.

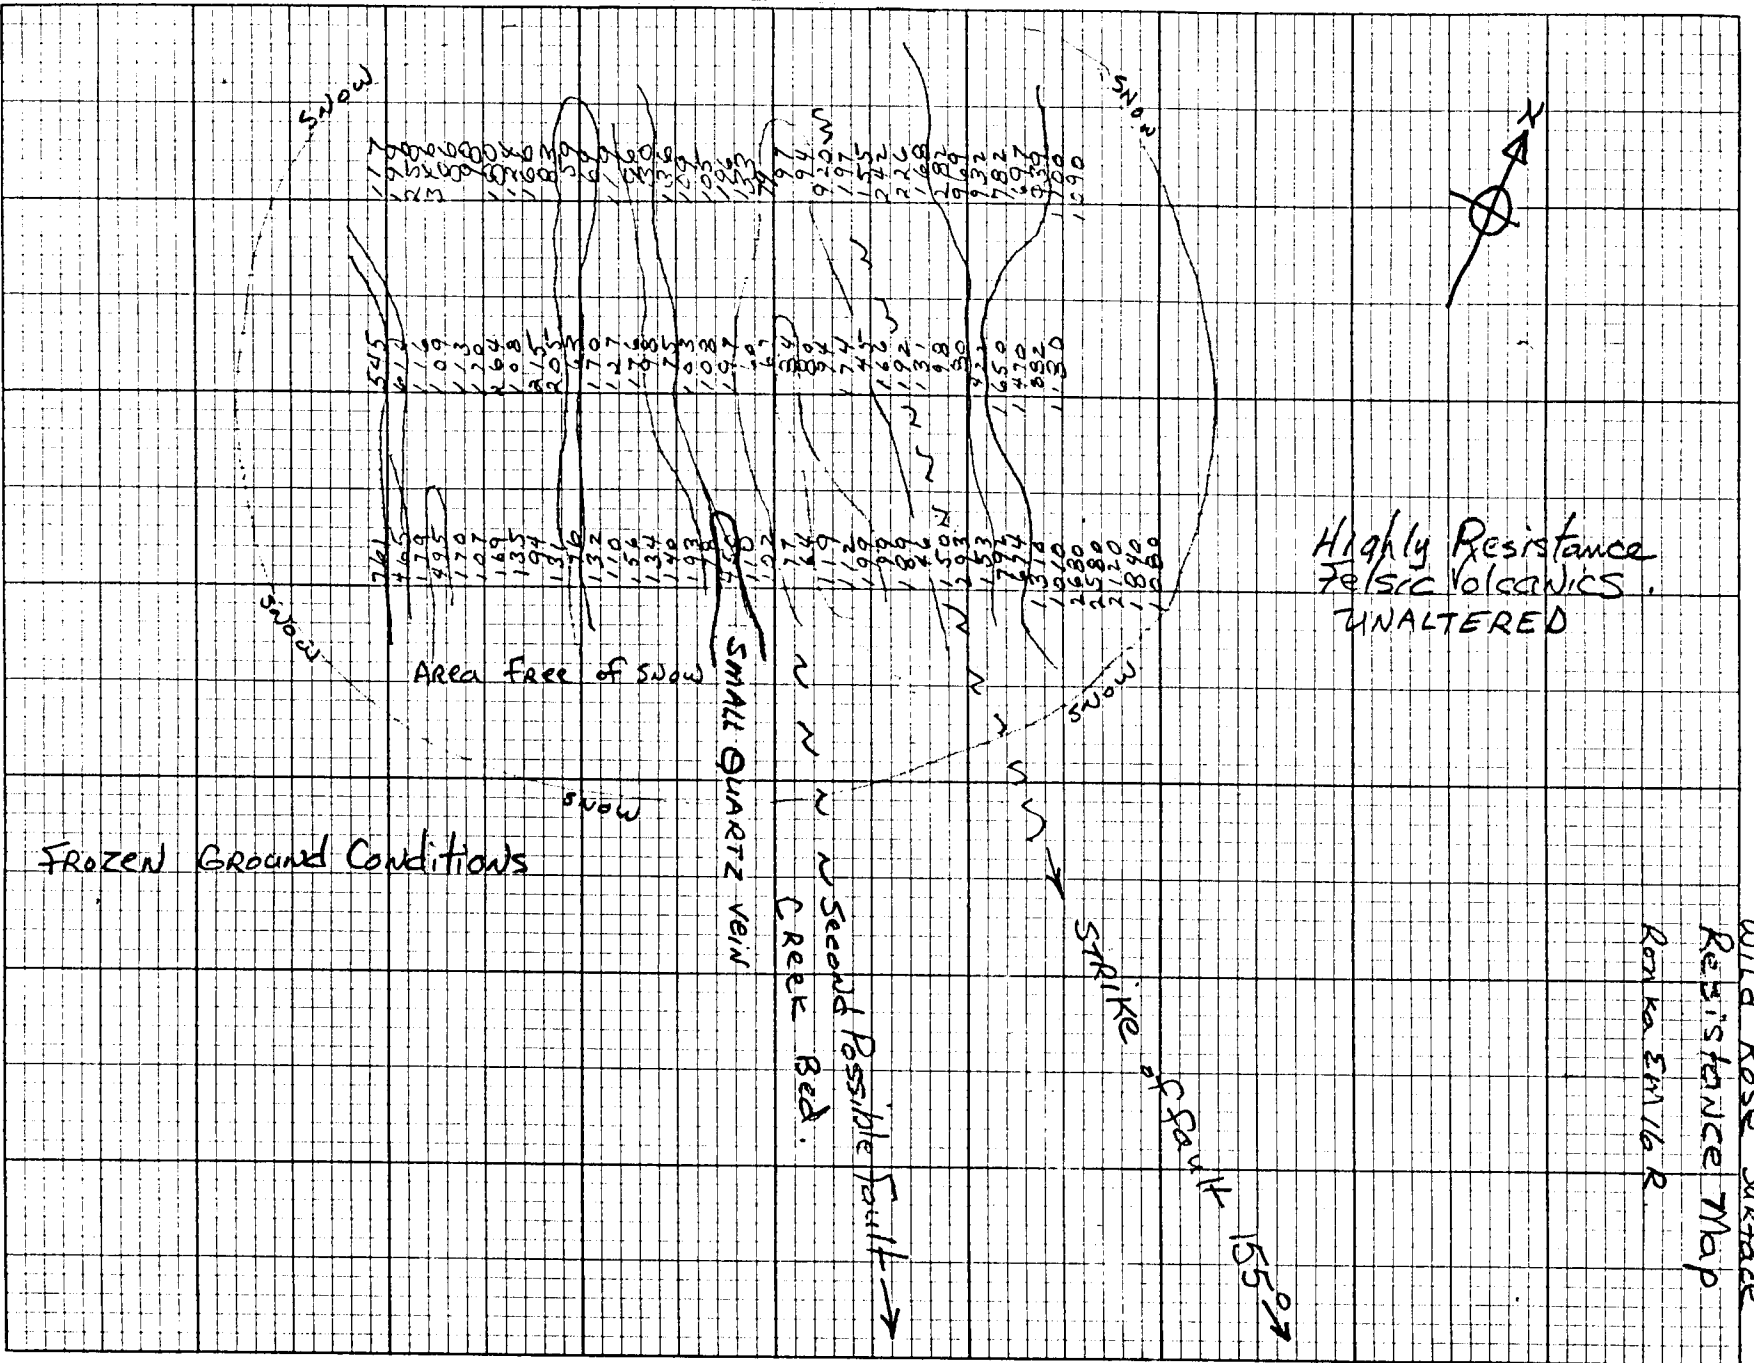

A traverse map follows that gives the location of water drainage, claim post line, camp, aproxment elevation, alteration, fault zones, Rock type, and Quartz's.

Starting at the Will Rose 1 and 2 initial post there was unaltered felsic volcanics. On crossing a fault the rock turned to basic volcanics. As one comes to the bottem of the hill the rock becomes very altered. A second fault running almost North South runs through the creek bottem. Traving further westerly up from the creek bottem the rock is very altered into a yellow-whiteish kaoloin clay. Further up the hill to the crest this alteration decreases, and finally on the far side of the crest it turns to a rusty Brown gossan.


10 meters up hill from the creek a sample of the clay was mixed with water and tested for ph. The sample ran 3.5 - Acidity.

25 meters above the creek and 50 meters north of the Base line a sample tag was located that was probably left by multinational exploration crew when they found the piece of float that ran 0.7 ounce gold per ton in 1989. That sample was never followed up to its source.

If I use a very old prospecting "Rule Of Thumb" ROCKS DON'T CLIMB UPHILL, then I should be pretty close to the source of the highgrade float.

Reference

- 1) We Follow in others Footsteps
- 2) 1989 Exploration Program, Chappell Property, Multinational Resources.
- 3) Buchanan, Larry, 1981, Precious Metal deposits of associated with volcanic environments. Arizona Geology. AGS Vol 14. P-237-262.

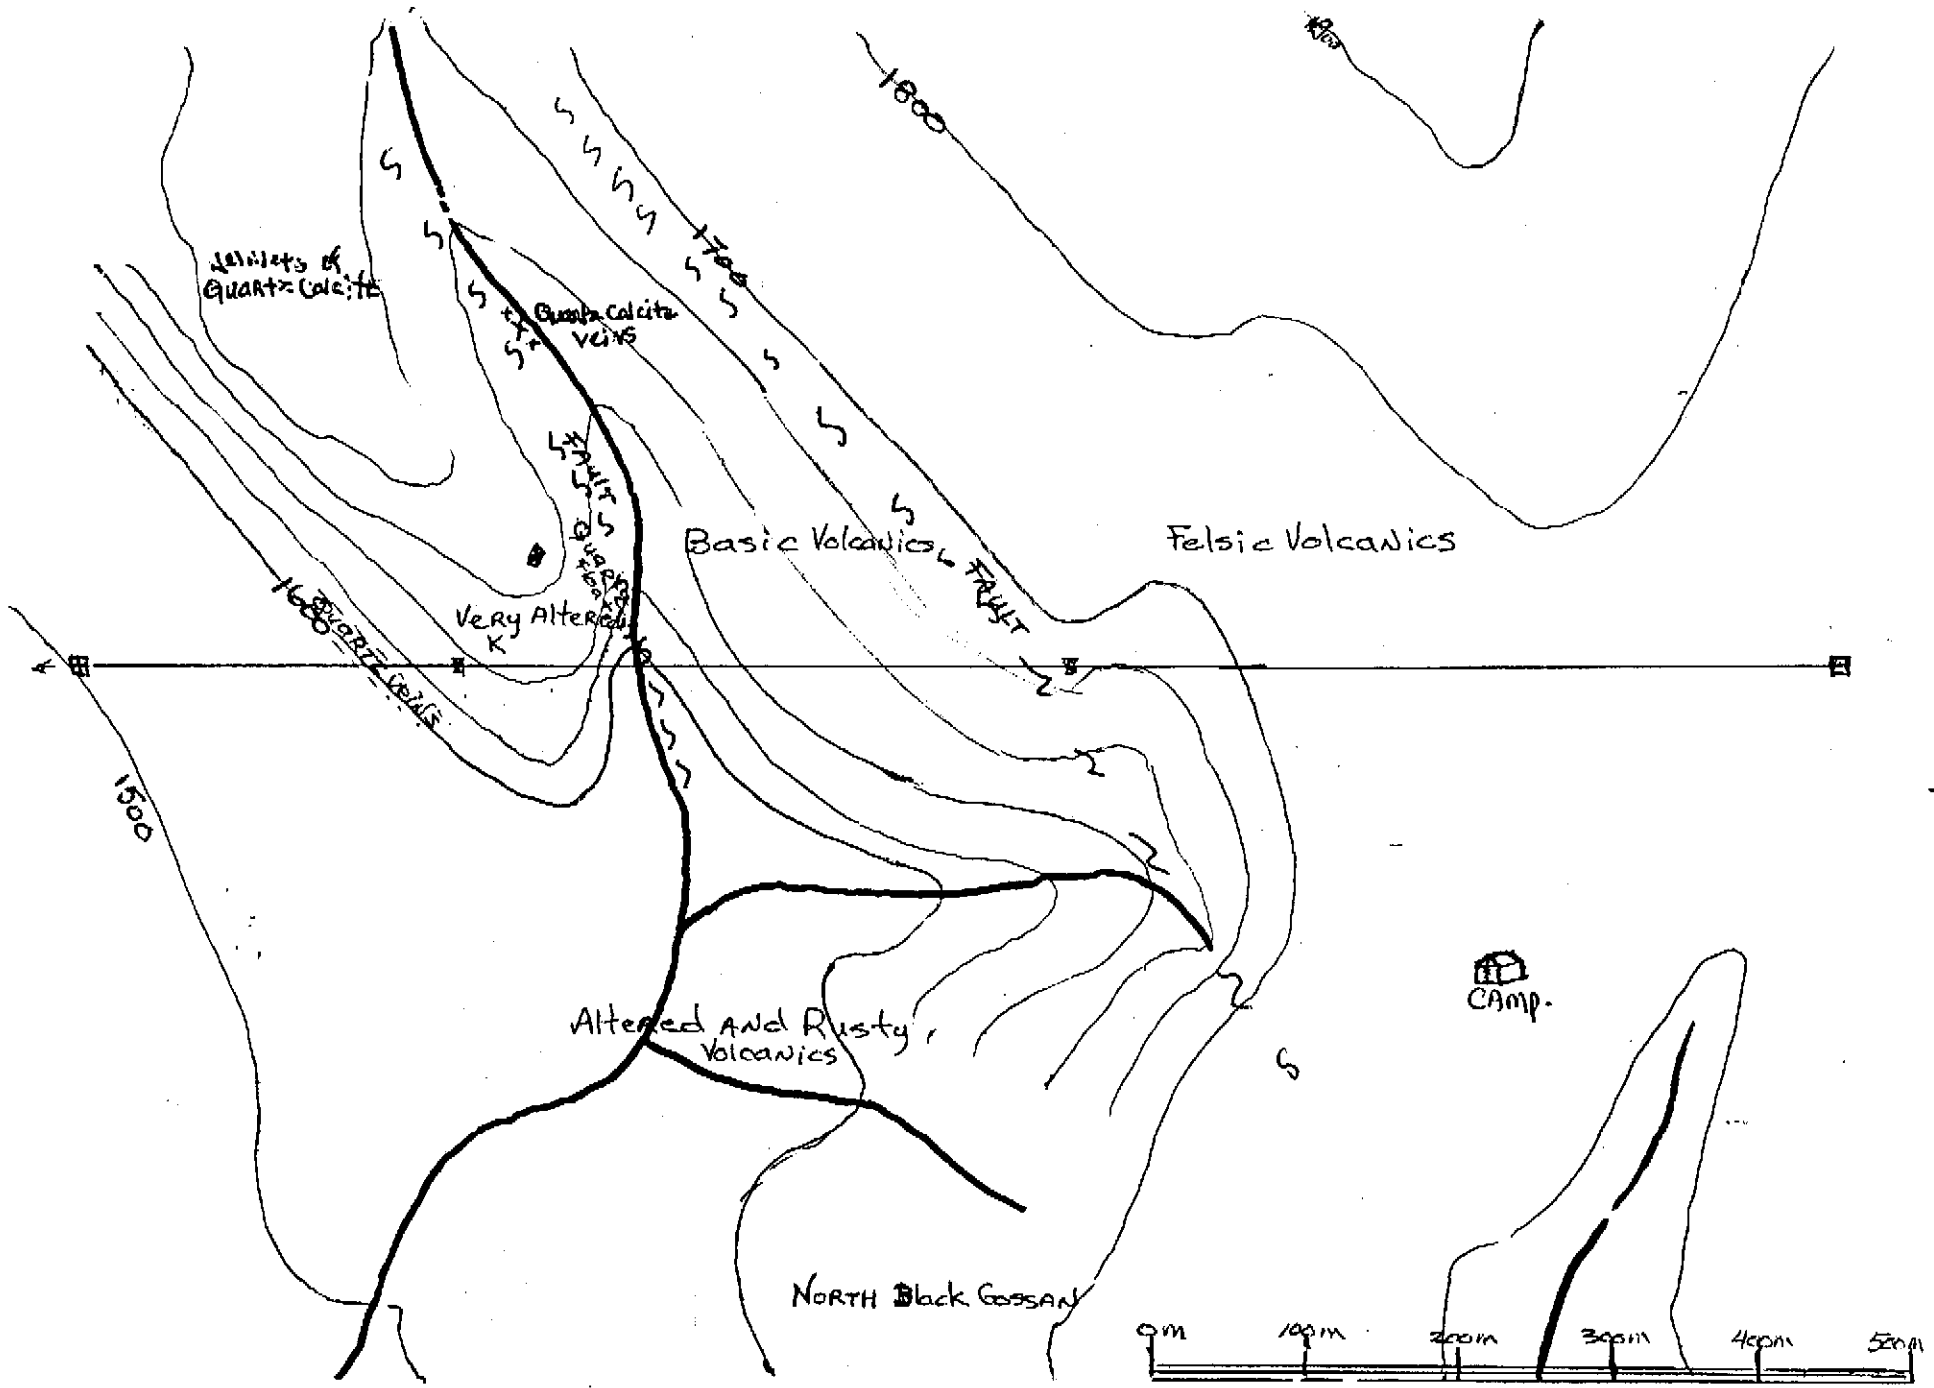

WILD ROSE 146 MINERAL CLAIMS
 Exploration Traverse